

LABOR AND MATERIALS


1	Copper	{ Connection	3/4"	\$	3.04
1	Lead	{			
1	Curb	{ Cock Valve	3/4 in.	\$	3.54
		{ T.S. & V.			
1	Service box	{ Short 3 1/2 x 4 1/2			
	Old returned	{ Long 4 1/2 x 5 1/2		\$	4.70
		{ Buff or Rdway			
28	Ft. 3/4 in.	{ Copper	Pipe at 35	\$	9.80
		{ C.I.			
		{ C.I.			
	Nipples	in. at		\$	
	Bushings	to in. at		\$	
	Red'g	{ Coupl'gs	to in. at	\$	
	Inc'g	{			
	Union	in. at		\$	
	Meter	in. at		\$	
	Lead Joints	at		\$	
	Compound Joints	at		\$	
	Hrs. Water Maint. Man-1	at		\$	
4	Hrs. Water Maint. Man-2	at 1.13		\$	4.52
5	Hrs. Labor	at 1.02		\$	5.10
	Hrs. Labor	at		\$	
1	Hrs. Compressor	at		\$	1.50
	Compensation Ins. at \$	per C.		\$	26
	Trucking			\$	1.00
	Pav't Patch			\$	8.10
				\$	
				\$	
				\$	
	O'head			\$	
	Tap by Gifford			\$	41.56

11-19-51

South St. Ave. No. 241

Name of Owner Colton

Labor and Mat'l. Report Nov. 19, 1951

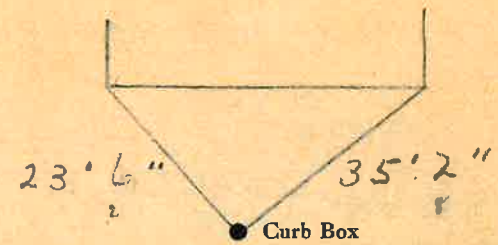

6" Main Elev. of Main at tap 4 1/2'

Gate at • Gate at •

28' to main 3/4" copper

• Curb Box Tap on Woodard St. Side.

TAX ID# 309.116-2-1