

LABOR AND MATERIALS

1 Copper } Connection 3/4" \$
~~Lead~~
 1 Curb } Cock } 3/4" in. ORISEAL MARK II
 Valve }
 F.S. & V. }
 1 Service box { Short ~~3 1/2 x 4 1/2~~
 Old returned { Long 4 1/2 x 5 1/2 } SAME
 Buff on Rdway } \$
 26 Ft. 3/4 in. { Copper } Pipe at \$
 Gal.
 Gal.
 Nipples in. at \$
 Bushings to in. at \$
 Red'g }
 Inc'g } Coupl'gs. to in. at \$
 Union in. at \$
 Meter in. at \$
 Lead Joints at \$
 Compound Joints at \$
 Maintenance Foreman \$
 Hrs. Water Maint. Man-1 at \$
 Hrs. Water Maint. Man-2 at \$
 Hrs. Garage Foreman at \$
 Hrs. Labor at \$
 Hrs. Compressor at \$
 Compensation Ins. at \$ per C \$
 Trucking \$
 Pav't Patch \$
 \$
 \$
 TAP MADE BY PECK & CO \$
 \$
 O'head OCT-17-1972 \$
 \$

South


St. ~~PP~~
 Ave. No. 249

Name of Owner

Duane Dubay

Labor and Mat'l. Report

Oct 17 1972

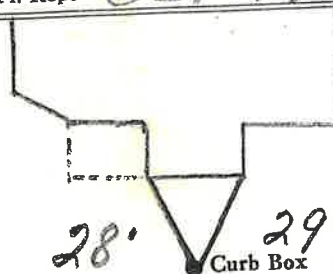

6" Main

Elev. of
 Main at tap 5'

Gate at •

• Gate at

26' to main

3/4" copper • Curb Box

ORISEAL

TAX ID # 309.16-5-5