

LABOR AND MATERIALS


1	Copper	Connection	3/4"	\$	2.76
1	Lead				
1	Curb	Cock Valve	3/4 in.	\$	3.49
		P. S. & V.			
1	Service box	Short 3/4 X 4 1/2			4.75
	Old returned	Long 4 1/2 X 5 1/2			
		Buff. or Rdway			
9	Ft.	Copper	3/4 in.	Pipe at 35	\$ 31.5
		C.I.			
		C.I.			
	Nipples	in. at		\$	
	Bushings	to in. at		\$	
	Red'g				
	Inc'g	Coupl'gs. to in. at		\$	
	Union	in. at		\$	
	Meter	in. at		\$	
	Lead Joints	at		\$	
	Compound Joints	at		\$	
1	Hrs. Water Maint. Man-1	at		\$	1.35
6	Hrs. Water Maint. Man-2	at	1.24	\$	7.44
18	Hrs. Labor-	at	1.13	\$	20.34
	Hrs. Labor-	at		\$	
1	Hrs. Compressor at			\$	1.50
	Compensation Ins. at \$	3.706 per C		\$	1.08
	Trucking			\$	1.00
	Pav't Patch			\$	9.45
	Tap by G. S. S. O. R. D.	8-4-52		\$	
	O'head			\$	
				\$	56.30

46.65
9.65

St. South
 Pt. 250
 Ave. No. 250

Name of Owner Thomas

Labor and Mat'l. Report Aug 4 1952

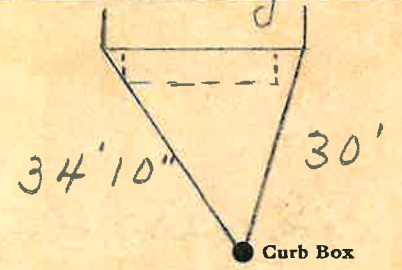

6" Main Elev. of Main at tap 5 1/2

Gate at ● Gate at ●

9' to main
 3/4" copper

● Curb Box

TAX ID # 309.16.6-15