

LABOR AND MATERIALS

1	Copper Lead	{ Connection	3/4"	\$	3.04
1	Curb	{ Cock Valve T.S. & V.	3/4" in.	\$	3.54
1	Service box Old returned	{ Short 3 1/2 x 4 1/2 Long 4 1/2 x 5 1/2 Buff or Rdway		\$	4.70
27	Ft. 3/4" in.	{ Copper C.I. C.I.	Pipe at	35	\$ 9.45
	Nipples	in. at		\$	
	Bushings	to in. at		\$	
	Red'g Inc'g	{ Coupl'gs to in. at		\$	
	Union	in. at		\$	
	Meter	in. at		\$	
	Lead Joints at			\$	
	Compound Joints at			\$	
3	Hrs. Water Maint. Man-1 at	1.23	\$	36.90	
8	Hrs. Water Maint. Man-2 at	1.13	\$	90.40	
12	Hrs. Labor at	1.02	\$	122.40	
	Hrs. Labor at		\$		
	Hrs. Compressor at		\$		
	Compensation Ins. at \$	per C.	\$	66	
	Trucking		\$	1.00	
	Pav't Patch		\$	9.45	
			\$		
			\$		
	O'head		\$		

Old Tap Disconnected \$56.81

Tap made by Miller
July 2 - 1951

255 SOUTH

South


St. Pt. Ave. No. 255

Name of Owner

Bosley

Labor and Mat'l. Report

July 3 1951

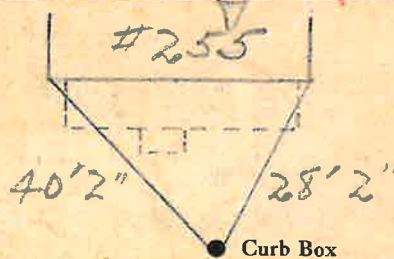

6" Main

Elev. of Main at tap 4 1/2'

Gate at ●

● Gate at

27' to main
3/4" copper

● Curb Box

TAX ID# 309.16-5-4