

LABOR AND MATERIALS

1. Copper Connection $\frac{3}{4}$ in.	\$ 2.94
1. Lead	
1. Curb { Cock Valve } $\frac{3}{4}$ in.	\$ 3.71
	T. S. & V.
1. Service box { Short $3\frac{1}{2}$ X $4\frac{1}{2}$ } Old returned { Long $4\frac{1}{2}$ X $5\frac{1}{2}$ } Buff or Rdway	\$ 5.90
25 Ft. $\frac{3}{4}$ in. { Copper } { G. I. } { C. I. }	Pipe at 30 \$ 7.50
Nipples..... in. at	\$
Bushings..... to..... in. at	\$
Red'g Inc'g { Coupl'gs..... to..... in. at	\$
Union..... in. at	\$
Meter..... in. at	\$
Lead Joints at	\$
Compound Joints at	\$
Hrs. Water Maint. Man—1 at	\$
9. Hrs. Water Maint. Man—2 at 9.1	\$ 8.19
6. Hrs. Labor— at 20	\$ 4.80
Hrs. Labor— at	\$
Hrs. Compressor at	\$
Compensation Ins. at \$ per C	\$ 2.9
Trucking	\$ 1.00
Pav't Patch	\$
copy M. of main	\$
O'head	\$
	\$ 34.33

98


St.
Pl. Ave. No. 257

South St

Name of Owner

CLOSON

Labor and Mat'l. Report Aug 25 1948

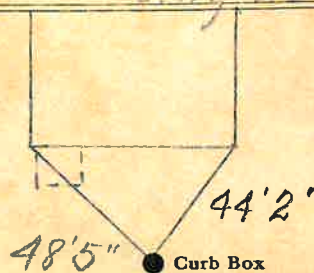

6" Main

Elev. of Main at tap 5

Gate at ●

● Gate at

25' to main
 $\frac{3}{4}$ " Copper

● Curb Box

TAX ID# 309.16-53