

Labor and Materials


Copper	Connection		\$ 3 20
Lead			
Curb	Cock Valve	in.	\$ 1 00
	T.S. & V.		
Service Box	Short $3\frac{1}{2} \times 4\frac{1}{2}$		\$ 1 20
	Lead		
	Bulb on Rdway		
2.5 Ft.	Copper	Pipe at	\$ 5 10
	Cast Iron		
Nipples	in. at		\$
Bushings	to in. at		\$
Red'g	Couplings	to in. at	\$
Inc'g			
Union	in. at		\$
Meter	in. at		\$
Lbs. Br. Stone	at		\$
Lbs. Sand	at		\$
Bags Cement	at		\$
Paving Brick	Mack Red Asphalt	at	\$
Lead Joints	at		\$
Leadite Joints	at		\$
7 Hrs.	Foreman	at	\$ 1 25
8 Hrs.	Common Labor	at	\$ 2 25
Hrs.	Common Labor	at	\$
Hrs.	Mason	at	\$
Hrs.	Mason's Helper	at	\$
Hrs.	Compressor	at	\$
Compensation	Ins		\$ 1 14
Trucking			\$ 1 00
Builders' Use of Water			\$

Total \$ 16.62

28-121 259 SOUTH

Labor and Material Report Sept 21 1928

199 South at (259)

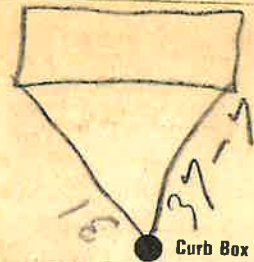

Main Elev of Main at tap 4 1/2

Gate at 25' to main 3/4" copper Gate at

Curb Box

New House

TAX ID# 309.16.5-2