


LABOR AND MATERIALS

1	Copper	Connection	3/4"	\$
1	Lead	Cock		\$
1	Curb	Valve	3/4 in. ORISEAL	\$
		T.S. & V.		\$
1	Service box	Short 3 1/2 x 4 1/2		\$
	Old returned	Long 4 1/2 x 5 1/2		\$
		Buff. or Rdway		\$
15	Ft.	3/4 in. Copper	Pipe at	\$
		G.I.		\$
		G.I.		\$
	Nipples	in. at		\$
	Bushings	to in. at		\$
	Red'g			\$
	Ino'g	Coupl'gs to in. at		\$
	Union	in. at		\$
	Meter	in. at		\$
	Lead Joints at			\$
	Compound Joints at			\$
	Maintenance Foreman			\$
	Hrs. Water Maint. Man-1 at			\$
	Hrs. Water Maint. Man-2 at			\$
	Hrs. Garage Foreman at			\$
	Hrs. Labor at			\$
	Hrs. Compressor at			\$
	Compensation Ins. at \$	per C		\$
	Trucking			\$
	Pav't Patch			\$
	Tap by LAREAUT CO.			\$
	O'head			\$

St. South
 Ave. No. 266

Name of Owner Laroy.

Labor and Mat'l. Report July 17 1969

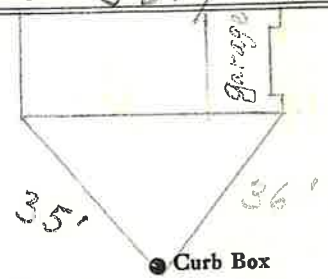

6" Main Elev. of Main at tap 4'
 Gate at • Gate at •

15' to MAIN
 3/4" COPPER • Curb Box
 ORISEAL

TAX ID # 309.16-11-7