

LABOR AND MATERIALS

Copper	} Connection		\$	
Lead				
Curb	} Cock Valve T. S. & V. }	in.	\$	
Service box		} Short 3½ x 4½ } Long 4½ x 5½ }		
Old returned				\$
9 Ft.	} Copper } } G.I. } } G.I. }	Pipe at	\$	
Nipples		in. at	\$	
Bushings		to in. at	\$	
Red'g } Inc'g }	} Coupl'gs	to in. at	\$	
Union		in. at	\$	
Meter	in. at	\$		
Compound Joints	at	\$		
Maintenance Foreman		\$		
Hrs. Water Maint. Man-1	at	\$		
Hrs. Water Maint. Man-2	at	\$		
Hrs. Garage Foreman	at	\$		
Hrs. Labor	at	\$		
Hrs. Compressor	at	\$		
Trucking		\$		
Pav't Patch		\$		
		\$		
		\$		
		\$		
		\$		


South

St. 2684
Pl. No. 270
Ave. No. 270

Name of Owner

Labor and Mat'l. Report

19 89

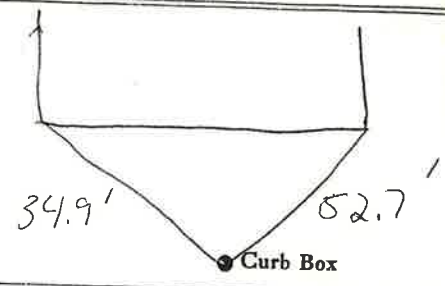

Main Elev. of Main at tap
Gate at • Gate at

9' to main

Copper • Curb Box

TAX ID # 309.16-11-8