


LABOR AND MATERIALS

1	Copper- Lead	Connection	1"	\$	
1	Curb	Cock Valve T. S. & V.	1 in. Used	\$	
1	Service box Old returned	{ Short 3 1/2 x 4 1/2 Long 4 1/2 x 5 1/2 Buff or Rdway }		\$	
11	Ft. 1 in.	{ Copper G. I. C. I. }	Pipe at	\$	
	Nipples	in. at		\$	
	Bushings	to in. at		\$	
	Red'g Inc'g	Coupl'gs	to in. at	\$	
1	Union	1" in. at	Cap to Iron	\$	
	Meter	in. at		\$	
	Lead Joints	at		\$	
	Compound Joints	at		\$	
	Maintenance Foreman			\$	
	Hrs. Water Maint. Man-1	at		\$	
	Hrs. Water Maint. Man-2	at		\$	
	Hrs. Garage Foreman	at		\$	
	Hrs. Labor	at		\$	
	Hrs. Compressor	at		\$	
	Compensation Ins. at \$	per C		\$	
	Trucking			\$	
	Pav't Patch			\$	
	Changeover from			\$	
	road up on sidewalk			\$	
	Aug 13-37 by			\$	
	O'head			\$	
				\$	

Corner of 40-44  
 South & Elm St.  
 Pl. Ave. No. 40-44

Name of Owner  
 Pat Herlihy  
 Measured in  
 Labor and Mat'l. Report Aug 14 1957

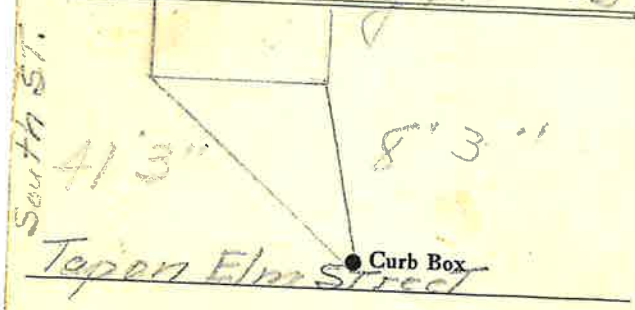

6" Main Elev. of Main at tap 6"  
 Gate at • Gate at

• Curb Box