

LABOR AND MATERIALS

1	Copper	} Connection	3/4" (MAY 11 ORISEAL)	\$
1	Curb			} Cock Valve
1	Service box	} Short 3 1/2 x 4 1/2	}	
	Old returned			} Long 4 1/2 x 5 1/2
13	Ft. 3/4 in.	} Copper	} Pipe at	
				} Galv.
	Nipples	in. at		
	Bushings	to in. at		\$
	Red'g } Inc'g	Coupl'gs to in. at		\$
	Union	in. at		\$
	Meter	in. at		\$
	Lead Joints at			\$
	Compound Joints at			\$
	Maintenance Foreman			\$
	Hrs. Water Maint. Man-1 at			\$
	Hrs. Water Maint. Man-2 at			\$
	Hrs. Garage Foreman at			\$
	Hrs. Labor at			\$
	Hrs. Compressor at			\$
	Compensation Ins. at \$	per C		\$
	Trucking			\$
	Pav't Patch			\$
	TAP MADE BY PECK			\$ 40
	MAY-11-1973			\$
	O'head			\$

South


St. No. 276  
Ave. No. 276

Name of Owner

Jerry Ross

Labor and Mat'l. Report

MAY 11 1973

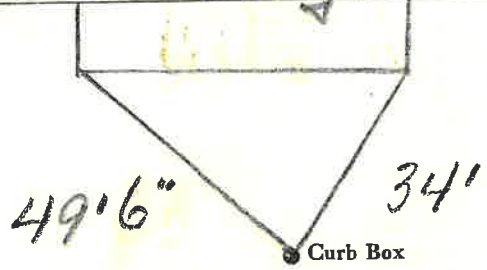

6" Main

Elev. of Main at tap 4'

Gate at •

• Gate at

13' to main

3/4" Copper • Curb Box

ORISEAL

TAX ID # 309.16-14-14