


South

St. Pl. Ave. No. 277

Name of Owner

Labor and Mat'l. Report 19 89

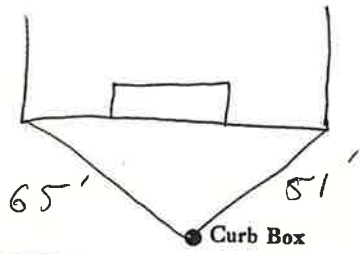

Main Elev. of Main at tap
 Gate at • Gate at

3/4" COPPER • Curb Box


South

St. Pl. Ave. No. 277

Name of Owner

TAX ID # 309.16-13-1

Labor and Mat'l. Report 19 90

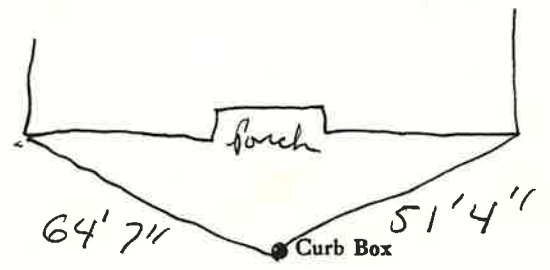

Main Elev. of Main at tap
 Gate at • Gate at

• Curb Box

