

LABOR AND MATERIALS

_____	Copper	} Connection	_____	\$	_____
_____	Lead		_____	\$	_____
_____	Curb	} Cock Valve T.S. & V. }	_____ in.	\$	_____
_____	Service box		{ Short 3-1/2 x 4-1/2 Long 4-1/2 x 5-1/2 }	_____	\$
_____	Old returned	_____		\$	_____
11'9"	Ft. 3/4"	} Copper S. C. }	_____ Pipe at	\$	_____
_____	Nipples		_____ in. at	\$	_____
_____	Bushings	_____ to _____ in. at	\$	_____	
_____	Red'g	_____	\$	_____	
_____	Inc'g	_____	\$	_____	
_____	Union	_____ in. at	\$	_____	
_____	Meter	_____ in. at	\$	_____	
_____	Compound Joints at	_____	\$	_____	
_____	Maintenance Foreman	_____	\$	_____	
_____	Hrs. Water Maint. Man - 1 at	_____	\$	_____	
_____	Hrs. Water Maint. Man - 2 at	_____	\$	_____	
_____	Hrs. Garage Foreman	_____ at	\$	_____	
_____	Hrs. Labor	_____ at	\$	_____	
_____	Hrs. Compressor at	_____	\$	_____	
_____	Trucking	_____	\$	_____	
_____	Pav't Patch	_____	\$	_____	
_____		_____	\$	_____	
_____		_____	\$	_____	
_____		_____	\$	_____	
_____		_____	\$	_____	

SOUTH

St.
Pt.
Ave. No.


280

Name of Owner

LARRY CLUTE ENT.

Labor and Mat'l. Report

4-14-2004

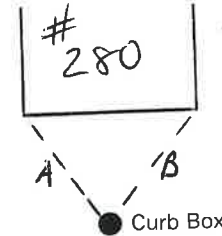

6" Main

Elev. of Main at tap

Gate at ●

● Gate at

SEWER MAIN IS 18'10" FROM CURB BOX.

● Curb Box

A = 34'6"

B = 38'7"

SEWER LATERAL RUNS BESIDE CURB BOX ON LEFTSIDE FACING BUILDING.