

LABOR AND MATERIALS

1 Copper } Connection $\frac{3}{4}$ " \$
 Lead }
 1 Curb } Cock } $\frac{3}{4}$ " Mueller
 Valve } ORISEAL
 T.S. & V. }
 1 Service box { Short $3\frac{1}{2}$ x $4\frac{1}{2}$ }
 Old returned { Long $4\frac{1}{2}$ x $5\frac{1}{2}$ }
 Buff or Rdway } \$
 26 Ft. $\frac{3}{4}$ in. { Copper } Pipe at \$
 { G.I. }
 { C.I. }
 Nipples in. at \$
 Bushings to in. at \$
 Red'g }
 Inc'g } Coupl'gs to in. at \$
 Union in. at \$
 Meter in. at \$
 Lead Joints at \$
 Compound Joints at \$
 Maintenance Foreman \$
 Hrs. Water Maint. Man-1 at \$
 Hrs. Water Maint. Man-2 at \$
 Hrs. Garage Foreman at \$
 Hrs. Labor at \$
 Hrs. Compressor at \$
 Compensation Ins. at \$ per C \$
 Trucking \$
 Pav't Patch \$
 Tapped by Gifford \$
 + Co. 4-23-63 \$
 O'head \$


285 SOUTH

South

St. Pl. Ave. No. 285

Name of Owner
 Geo. L. Smith

Labor and Mat'l. Report April 23 1963

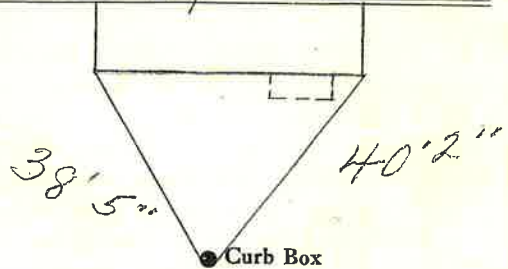

6" C.I. Main Elev. of Main at tap 4'

Gate at • Gate at

26' to MAIN

$\frac{3}{4}$ " Copper • Curb Box

ORISEAL

TAX ID# 309.16-16-1.1