

WEST STATE ST.  
 Gate at ●

Main at tap ●  
 Elev. of Main at tap 4'5"  
 4" SEWER @ 19'  
 Curb Box ●


A = 36'6"  
 B = 19'5"  
 14' to main

LABOR AND MAT'L. REPORT ~~Summer of 2002~~  
 TAX ID # 309.16-16-1.2  
 Name of Owner

South  
 Ave. No. 287  
 St. Pl. 287

South  
 St. Pl. Ave. No. 287  
 Name of Owner  
 TAX ID # 309.16-16-1.2  
 Labor and Mat'l. Report ~~Summer of 2002~~

14' to main  
 B = 19'5"  
 A = 36'6"  
 Curb Box ●  
 4" SEWER @ 19'  
 Elev. of Main at tap 4'5"  
 Gate at ●

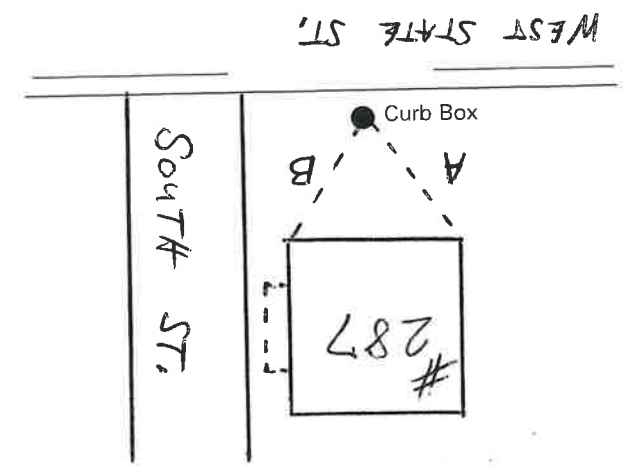

WEST STATE ST.  
 Gate at ●

