

SOUTH

St. Pt. Ave. No. 45-47

Name of Owner

LA POINT

Labor and Mat'l. Report

NOV. 1999

SPRINKLER LINE
TAP ON ELM ST

● Curb Box

6" Main

Elev. of Main at tap 5'


Gate at ●

● Gate at

4" Copper

ELM ST

● Curb Box GATE

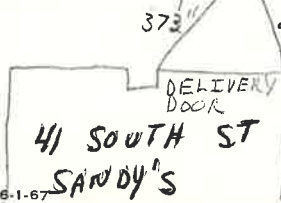

4" LINE
6" GATE
W/REDUCER

LSM-5C-6.1-67

83 - - 1940 45 - SOUTH

St.

~~Pl.~~

South

Ave. No. 45


Name of Owner

Thompson Est

Labor and Mat'l. Report

JULY 8 1990

South St.

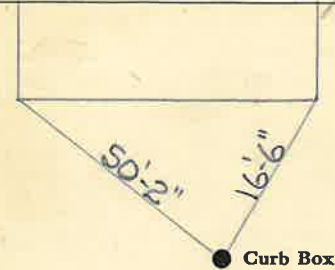

● Curb Box

6" Main

Elm St.

Elev. of Main at tap 4 1/2'

Gate at ●

● Gate at

25' to main
1" copper

● Curb Box

TAX ID # 309.28-1-12

