


46-56-50073

Labor and Material Report Apr 27 19 29

South St (4 Thimern Bldg)

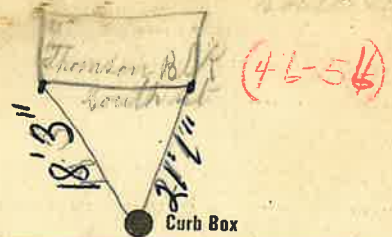

10 Main Elev of Main at tap 5'6"

Gate at 5 1/2" to main Gate at

Curb Box

6" Tap


Sprinkler system

2" Tap S. E. CORNER 46-SOUTH

St. Pl. 46-54 Ave. No.

Name of Owner TAX ID# 309.28-2-6  
GINSBERG

Labor and Mat'l. Report Apr. 21 1955

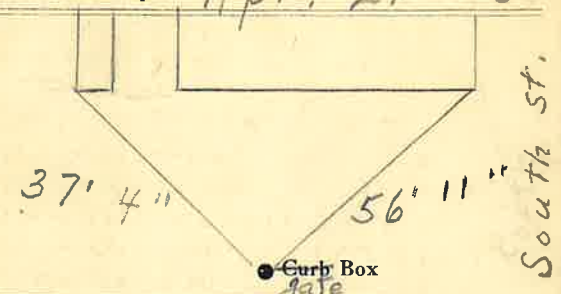

6" Main Elev. of Main at tap 7'

Gate at 20' to main Gate at 2" COPPER

Curb Box

TAP ON ELM ST.  
SHUT OFF IS AT  
MAIN

### Labor and Materials

Copper } Connection.....	\$	
Lead } Connection.....	\$	
1 Curb } Curb Valve } 6" in.	\$	52.00
1 Service Box } Short 3 1/2 x 4 1/2 } gate box at 7.00	\$	
Old returned } Long 4 1/2 x 5 1/2 } Buff or Rdway	\$	57.5
5 Ft. 6" in. } Copper Galv. Iron } Pipe at	\$	3.85
Nipples..... in. at.....	\$	
Bushings..... to..... in. at.....	\$	
Red'g } Couplings..... to..... in. at.....	\$	
Inc'g } Couplings..... to..... in. at.....	\$	
Union..... in. at.....	\$	
Meter..... in. at.....	\$	
Lbs. Br. Stone at.....	\$	
Lbs. Sand at.....	\$	
Bags Cement at.....	\$	
Paving Brick } Mack } at.....	\$	
Lead Joints at.....	\$	2.50
1 Leadite Joints at.....	\$	.68
30 Hrs. Foreman at.....	\$	18.75
3 Hrs. Common Labor at.....	\$	1.50
51 Hrs. Common Labor at.....	\$	20.72
Hrs Mason at.....	\$	
Hrs Mason's Helper at.....	\$	
6 Hrs. Compressor at.....	\$	9.00
Compensation Ins.....	\$	1.08
Trucking.....	\$	1.00
Builders' Use of Water.....	\$	

Total \$ 174.63  
Patch 2.60  
152.03

### LABOR AND MATERIALS

Copper } Same } Connection 6" X 2".....	\$	
Lead } Connection 6" X 2".....	\$	
Curb } Curb Valve } in.....	\$	
Same } Service box } Short 3 1/2 x 4 1/2 } Old returned } Long 4 1/2 x 5 1/2 } Buff or Rdway.....	\$	
20 Ft. 2 in. } Copper } Pipe at 177	\$	35.40
1 Nipples 2 in. at 6" Long Brass	\$	1.75
Bushings..... to..... in. at.....	\$	
Red'g } Coupl'gs..... to..... in. at.....	\$	
Inc'g } Coupl'gs..... to..... in. at.....	\$	
Union..... in. at.....	\$	
Meter..... in. at.....	\$	
Lead Joints at.....	\$	
Compound Joints at.....	\$	
14 Maintenance Foreman 1.51	\$	21.14
Hrs. Water Maint. Man-1 at.....	\$	
14 Hrs. Water Maint. Man-2 at 1.24	\$	17.36
Hrs. Garage Foreman..... at.....	\$	
42 Hrs. Labor..... at 1.13	\$	47.46
Hrs. Compressor at.....	\$	
Compensation Ins. at \$4.29 per C	\$	3.69
Trucking.....	\$	1.50
Pav't Patch 4-21-55	\$	24.72
Tap by Miller & Co.	\$	
1-2" female Adapter	\$	3.75
O'head.....	\$	
	\$	166.77

132.05

### LABOR AND MATERIALS

Copper	}	Connection			\$	
Lead						
Curb	{	Cock Valve T. S. & V.			\$	
Service Box			}	Short 3 1/2 x 4 1/2		
Old returned				Long 4 1/2 x 5 1/2		
		Buff. or Rdway			\$	
Ft.						
	}	}	Pipe at		\$	
		Copper				
		Galv Iron				
		Cast Iron				
Nipples			in. at		\$	
Bushings		to	in. at		\$	
Red'g Inc'g	}	Couplings	to	in. at	\$	
Union			in. at		\$	
Meter			in. at		\$	
Lead Joints			at		\$	
Leadite Joints			at		\$	
Hrs. Foreman			at		\$	
Hrs. Chauffeur			at		\$	
Hrs. Tapper			at		\$	
Hrs. Labor			at		\$	
Hrs. Labor			at		\$	
Hrs. Compressor			at		\$	
Compensation Ins.					\$	
Trucking					\$	
Builders Use of Water					\$	
					\$	
					\$	

54-50 UT 3

St.  
Pt.  
Ave. No. 54

South

Name of Owner (#7 Thomson Block)

Labor and Mat'l. Report 19 14

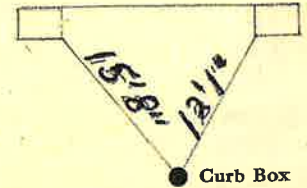

Main Elev. of Main at tap.....

Gate at ● ● Gate at

● Curb Box