


**Labor and Materials**

1	Copper	Connection	.....	\$	.....
	<del>Lead</del>				
1	Curb	Cock Valve	..... in.	\$	.....
		<del>P.S. &amp; V</del>			
1	Service Box	Short 3 1/2 x 4 1/2	.....	\$	.....
	Old returned	Long 4 1/2 x 5 1/2	.....	\$	.....
		Buff. or Rdway			
36	Ft.	Copper	..... in.	\$	.....
		Galv. Iron	.....	\$	.....
		Cast Iron	.....	\$	.....
	Nipples	..... in. at	.....	\$	.....
	Bushings	..... to ..... in. at	.....	\$	.....
	Red'g Inc'g	Couplings	..... to ..... in. at	\$	.....
	Union	..... in. at	.....	\$	.....
	Meter	..... in. at	.....	\$	.....
	Lbs. Br. Stone	at	.....	\$	.....
	Lbs. Sand	at	.....	\$	.....
	Bags Cement	at	.....	\$	.....
	Paving Brick	Mack Red Asphalt	..... at	\$	.....
	Lead Joints	at	.....	\$	.....
	Leadite Joints	at	.....	\$	.....
	Hrs. Foreman	at	.....	\$	.....
	Hrs. Common Labor	at	.....	\$	.....
	Hrs. Common Labor	at	.....	\$	.....
	Hrs. Mason	at	.....	\$	.....
	Hrs. Mason's Helper	at	.....	\$	.....
	Hrs. Compressor	at	.....	\$	.....
	Compensation Ins	.....	.....	\$	.....
	Trucking	.....	.....	\$	.....
	Builders' Use of Water	.....	.....	\$	.....
	<b>Total</b>	<b>\$</b>	.....		

59-50073 - 16  
 Labor and Material Report J 10/17/12 19 25

27 South D.O.

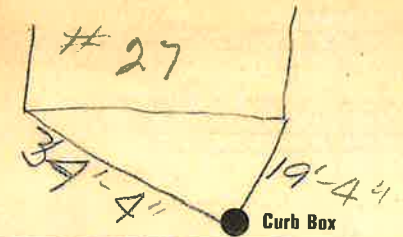

Main Elev of Main at tap

---

Gate at 36' to MAIN Gate at

● Curb Box

# 59-# 61-# 63  
 TAX ID # 304.28-1-9