


### Labor and Materials

1	Copper	Connection	.....	\$	.....	
1	Lead	.....		\$	.....	
1	Curb	Cock Valve P.S. & V. } in. ....		\$	.....	
1	Service Box	} Short 3/4x4 1/2 Long 4 1/2x5 1/2 Buff. or Rdway		\$	.....	
	Old returned				\$	.....
7	Ft.	Copper Galv. Iron } Pipe at		\$	.....	
	in.	Cast Iron }		\$	.....	
	Nipples	in. at		\$	.....	
	Bushings	to in. at		\$	.....	
	Red'g Inc'g	Couplings to in. at		\$	.....	
	Union	in. at		\$	.....	
	Meter	in. at		\$	.....	
	Lbs. Br. Stone	at		\$	.....	
	Lbs. Sand	at		\$	.....	
	Bags Cement	at		\$	.....	
	Paving Brick	Mack Red Asphalt } at		\$	.....	
	Lead Joints	at		\$	.....	
	Leadite Joints	at		\$	.....	
	Hrs. Foreman	at		\$	.....	
	Hrs. Common Labor	at		\$	.....	
	Hrs. Common Labor	at		\$	.....	
	Hrs. Mason	at		\$	.....	
	Hrs. Mason's Helper	at		\$	.....	
	Hrs. Compressor	at		\$	.....	
	Compensation Ins			\$	.....	
	Trucking			\$	.....	
	Builders' Use of Water			\$	.....	
	Total \$				\$	.....

### Labor and Material Report

16-  
July 27 18 19 38

9-10-11-12 Thompson Building  
56-60-62-62A S-4/1A SK 1

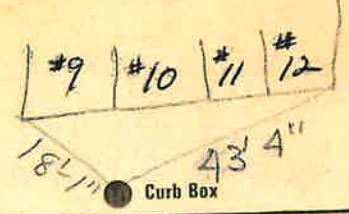

10" Main Elev of Main at tap 5 1/2  
 Gate at 7' to main ● Gate at

● Curb Box

12/5/2023 - 10" WATER MAIN  
PER D. GIRARD