

Labor and Materials


1	Copper	Connection	\$
	Lead				
1	Curb	Cock Valve T.S. & V. { in.	\$
1	Service Box	Short 3 1/2 x 4 1/2	}	\$
	Old returned	Long 4 1/2 x 5 1/2			
		Buff. or Rdway			
7	Ft. in.	Copper Galv. Iron Cast Iron {	Pipe at	\$
	Nipples in. at		\$
	Bushings to	in. at	\$
	Red'g	} Couplings to	\$
	Inc'g	 in. at		
	Union in. at		\$
	Meter in. at		\$
	Lbs. Br. Stone	at		\$
	Lbs. Sand	at		\$
	Bags Cement	'at		\$
	Paving Brick	{ Mack Red Asphalt } at		\$
	Lead Joints	at		\$
	Leadite Joints	at		\$
	Hrs. Foreman	at		\$
	Hrs. Common Labor	at		\$
	Hrs. Common Labor	at		\$
	Hrs. Mason	at		\$
	Hrs. Mason's Helper	at		\$
	Hrs. Compressor	at		\$
	Compensation Ins		\$
	Trucking		\$
	Builders' Use of Water		\$
	Total \$

66 SOUTH

Labor and Material Report

1928

#40 SOUTH 310

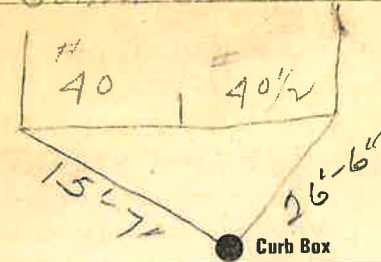

10 Main

Elev of Main at tap 5'

Gate at 7' to main

Gate at

● Curb Box

#64- #66 TAX ED
#309.28-2-8

12/5/2023 - 10" WATER MAIN
PER D. GIRARD