


LABOR AND MATERIALS

1	Copper	Connection	1"	\$
1	Curb	Cock Valve	1" in. ORISEAL	\$
1	Service box	Short 3 1/2 x 4 1/2		
	Old returned	Long 4 1/2 x 5 1/2		
		Buff. or Rdway		\$
28	Ft. 1" in.	Copper	Pipe at	\$
	Nipples	in. at		\$
	Bushings	to in. at		\$
	Red'g			
	Inc'g	Coupl'gs to in. at		\$
	Union	in. at		\$
	Meter	in. at		\$
	Lead Joints	at		\$
	Compound Joints	at		\$
	Maintenance Foreman			\$
	Hrs. Water Maint. Man-1	at		\$
	Hrs. Water Maint. Man-2	at		\$
	Hrs. Garage Foreman	at		\$
	Hrs. Labor	at		\$
	Hrs. Compressor	at		\$
	Compensation Ins. at \$	per C		\$
	Trucking			\$
	Pav't Patch			\$
	Tap made by Peck			\$6
	O'head	April 20 1973		\$

South St. Ave. No. 69

Name of Owner
A.B.C. Equipment

Labor and Mat'l. Report April 20 1973

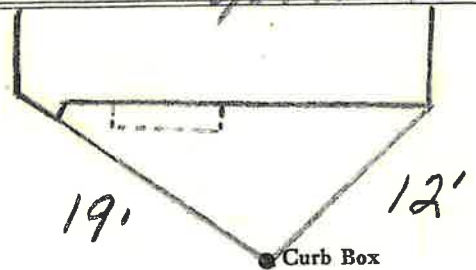

BROAD ST.

6" Main Elev. of Main at tap 5 1/2'

Gate at 28' to MAIN 1" COPPER Gate at

TAP ON 6" MAIN ON BROAD ST. - CORP STOP 18' FROM 6" BROAD ST. GATE. TAX ID# 309.28-1-7