

Labor and Materials


1	Copper	Connection	\$
	Lead		
1	Curb	Cock Valve in	\$
		T.S. & V.	
1	Service Box	Short $3\frac{1}{2} \times 4\frac{1}{2}$	\$
	Old returned	Long $4\frac{1}{2} \times 5\frac{1}{2}$	
		Part of Redway	
7	Ft. $3\frac{1}{4}$ in.	Copper	Pipe at	\$
		Galv. Iron	
		Cast Iron	
	Nipples	in. at	\$
	Bushings	to in. at	\$
	Red'g	Couplings	to in. at	\$
	Inc'g		
	Union	in. at	\$
	Meter	in. at	\$
	Lbs. Br. Stone	at	\$
	Lbs. Sand	at	\$
	Bags Cement	at	\$
	Paving Brick	Mack	at	\$
		Red	
		Asphalt	
	Lead Joints	at	\$
	Leadite Joints	at	\$
	Hrs. Foreman	at	\$
	Hrs. Common Labor	at	\$
	Hrs. Common Labor	at	\$
	Hrs. Mason	at	\$
	Hrs. Mason's Helper	at	\$
	Hrs. Compressor	at	\$
	Compensation Ins	\$
	Trucking	\$
	Builders' Use of Water	\$
	Total	\$	

72 SOUTH

Labor and Material Report

July 12 1921

44 South St

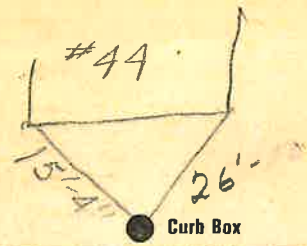

Curb Box

10" Main

Elev of Main at tap 6'

Gate at

Gate at

7' to MAIN
3/4" copper

Curb Box

TAX ID# 309.28-2-10