

Labor and Materials


1	Copper	Connection	3/4"	\$ 2.60
	Lead			
1	Curb	Cock Valve	3/4" in.	\$ 2.27
		T.S. & V.		
1	Service Box	Short 3/4 x 4 1/2		\$ 1.59
	Old returned	Long 4 1/2 x 5 1/2		
		Buff. or Rdway		
8	Ft.	3/4 in.	Copper Galv. Iron Pipe at	\$ 1.44
			Cast Iron	
	Nipples	in. at		\$
	Bushings	to in. at		\$
	Red'g Inc'g	Couplings	to in. at	\$
	Union	in. at		\$
	Meter	in. at		\$
	Lbs. Br. Stone	at		\$
	Lbs. Sand	at		\$
	Bags Cement	at		\$
	Paving Brick	Mack Red Asphalt	at	\$
	Lead Joints	at		\$
	Leadite Joints	at		\$
5	Hrs. Foreman	at		\$ 3.13
2	Hrs. Common Labor	at	Tapper	\$ 1.00
12	Hrs. Common Labor	at		\$ 5.40
	Hrs. Mason	at		\$
	Hrs. Mason's Helper	at		\$
1 1/2	Hrs. Compressor	at		\$ 1.50
	Compensation Ins			\$.29
	Trucking			\$ 1.00
	Builders' Use of Water	Pitali		\$ 23.00
Total \$				43.22

31-104

84 SOUTH

Labor and Material Report

1931

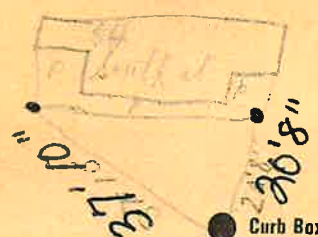

Main

Elev of Main at tap

Gate at

Gate at

8' to main
3/4" copper

Curb Box

Old tap shut off

TAX ID # 309.28-6-6