

LABOR AND MATERIALS


Copper } Connection		\$
Lead } Connection		\$
Curb } Clock Valve	} in.	\$
} T. S. & V.		
Service box } Short 3 1/2 X 4 1/2	} \$	
Old returned } Long 4 1/2 X 5 1/2		
} Buff or Rdway		
Ft. } in.	Copper } Galv. Iron } Cast Iron } Pipe at	\$
Nipples	in. at	\$
Bushings	to in. at	\$
Red'g } Inc'g } Couplings	to in. at	\$
Union	in. at	\$
Meter	in. at	\$
Lead Joints at		\$
Compound Joints at		\$
Hrs. Foreman at		\$
Hrs. Chauffeur at		\$
Hrs. Tapper at		\$
Hrs. Labor at		\$
Hrs. Labor at		\$
Hrs. Compressor at		\$
Compensation Ins.		\$
Trucking		\$
Builders Use of Water		\$
<i>M. L. H. & Maguire</i>		\$
		\$
		\$
		\$
		\$

86- SOUTH

St. PT.
 Ave. No. 86

Name of Owner _____

Labor and Mat'l. Report Aug. 1948

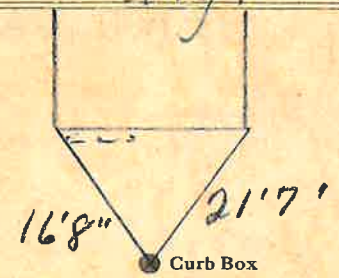

TAX ID# 309.28-6-7

Main _____ Elev. of Main at tap _____

Gate at ● _____ ● Gate at _____

● Curb Box