

### Labor and Materials


Copper	}	Connection.....	\$.....
Lead			
Curb	}	Cock	in .....
		Valve	
		T. S. & V.	
Service Box	}	Short 3½ x 4½	\$.....
Old returned		Long 4½ x 5½	
		Buff. or Rdway	
7 Ft. 3/4 in.	}	Copper	Pipe at .....
		Galv Iron	
		Cast Iron	
Nipples		in. at.....	\$.....
Bushings		to .....	in. at.....
Red'g. Inc'g	}	Couplings.....	to .....
Union		in. at .....	\$.....
Meter		in. at .....	\$.....
Lead Joints at .....			\$.....
Leadite Joints at .....			\$.....
Hrs. Foreman at .....			\$.....
Hrs. Chauffeur at .....			\$.....
Hrs. Tapper at .....			\$.....
Hrs. Labor at .....			\$.....
Hrs. Labor at .....			\$.....
Hrs. Compressor at .....			\$.....
Compensation Ins. ....			\$.....
Trucking .....			\$.....
Builders Use of Water .....			\$.....
			\$.....
			\$.....
88 SOUTH

St. South  
 Pl. 88  
 Ave. No. 88

Name of Owner \_\_\_\_\_

Labor and Mat'l. Report May 31 1917

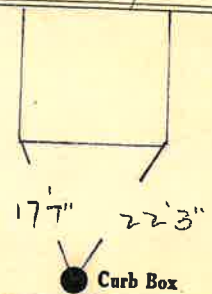

10 Main Elev. of Main at tap.....

Gate at • 7' to MAIN • Gate at  
3/4" COPPER  
 • Curb Box