

### Labor and Materials



1	Copper	Connection 1"	\$ 3.81
1	Lead		
1	Curb	Cock Valve P.S. & V. 1" in.	\$ 3.59
1	Service Box	Short 1 1/2 x 1 1/2	\$ 1.59
	Old returned	Long 4 1/2 x 5 1/2 Buff. or Rdway	
8	Pt. 1"	Copper Pipe at	\$ 1.76
		Cast Iron	
	Nipples	in. at	\$
	Bushings	to in. at	\$
	Red'g Inc'g	Couplings to in. at	\$
	Union	in. at	\$
	Meter	in. at	\$
	Lbs. Br. Stone	at	\$
	Lbs. Sand	at	\$
	Bags Cement	at	\$
	Paving Brick	Mack Red Asphalt at	\$
	Lead Joints	at	\$
	Leadite Joints	at	\$
5	Hrs. Foreman	at	\$ 3.13
2	Hrs. Common Labor	at Tapper	\$ 1.00
12	Hrs. Common Labor	at	\$ 5.40
	Hrs. Mason	at	\$
	Hrs. Mason's Helper	at	\$
1 1/2	Hrs. Compressor	at	\$ 1.50
	Compensation Ins.		\$ .29
	Trucking		\$ 1.00
	Builders' Use of Water	Patch	\$ 23.00

Total \$ 46.07

### Labor and Material Report

90 SOUTH

1931

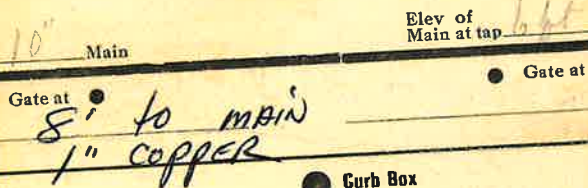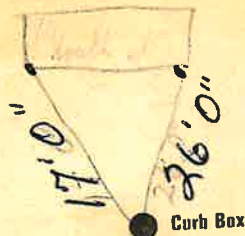

Old tap shut off

Shot off at  
Curb 11/18/74

TAX ID# 309.28-6-9