

Labor and Materials

1	Copper	Connection	3/4"	\$ 2.60
	Lead			
1	Curb	Cock Valve	3/4" in.	\$ 2.27
		T. S. & V.		
1	Service Box	Short	3 1/2 x 4 1/2	\$ 1.38
	Old returned	Long	4 1/2 x 5 1/2	
		Buff. or Rdway		
10	Ft.	3/4" in.	Copper Galv. Iron Pipe at	\$ 1.80
			Cast Iron	
	Nipples	in. at		\$
	Bushings	to in. at		\$
	Red'g Inc'g	Couplings to in. at		\$
	Union	in. at		\$
	Meter	in. at		\$
	Lbs. Br. Stone	at		\$
	Lbs. Sand	at		\$
	Bags Cement	at		\$
	Paving Brick	Mack Red Asphalt at		\$
	Lead Joints	at		\$
	Leadite Joints	at		\$
5	Hrs. Foreman	at		\$ 2.13
2	Hrs. Common Labor	at. Tapper		\$ 1.-
17	Hrs. Common Labor	at		\$ 5.40
	Hrs. Mason	at		\$
	Hrs. Mason's Helper	at		\$
1 1/2	Hrs. Compressor	at		\$ 1.50
	Compensation Ins			\$.79
	Trucking			\$ 1.-
	Builders' Use of Water	Patch		\$ 23.-
Total \$				43.37


31-107

92 SOUTH

Labor and Material Report

1921

3/4" tap at 92' south of

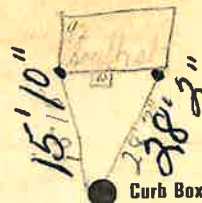

10" Main

Elev of Main at tap

Gate at

Gate at

10' to main
3/4" copper

Curb Box

Old tap shut off