

Labor and Materials

1	Copper } Connection	3/4	\$ 2.60	
	Lead			
1	Curb } Cock	3/4 in.	\$ 2.27	
	Valve			
	T.S. & V.			
1	Service Box } Short 3 1/2 x 4 1/2		\$ 1.59	
	Old returned } Long 4 1/2 x 5 1/2			
		Buff. or Rdway		
2.5	Ft. 3/4 in. } Copper	Pipe at	\$ 4.50	
				Galv. Iron
		Cast Iron		
	Nipples	in. at	\$	
1	Bushings	3/4" to 1/2" in. at	\$ 1.0	
	Red'g } Couplings	to in. at	\$	
	Inc'g			
	Union	in. at	\$	
	Meter	in. at	\$	
	Lbs. Br. Stone at		\$	
	Lbs. Sand at		\$	
	Bags Cement at		\$	
	Paving Brick } Mack	at	\$	
				Red
				Asphalt
	Lead Joints at		\$	
	Leadite Joints at		\$	
5	Hrs. Foreman at		\$ 3.13	
2	Hrs. Common Labor at	Tapper	\$ 1.00	
17	Hrs. Common Labor at		\$ 5.40	
	Hrs. Mason at		\$	
	Hrs. Mason's Helper at		\$	
1 1/2	Hrs. Compressor at		\$ 1.50	
	Compensation Ins		\$.29	
	Trucking		\$ 1.00	
	Builders' Use of Water	Patel	\$ 23.00	
Total \$			46.38	


31-108

93 SOUTH

Labor and Material Report

19

3/4" top of 93 South st

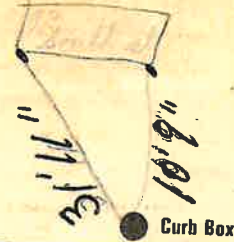

10" Main

Elev of Main at tap

Gate at

25' to main
3/4" copper

Gate at

Old tap removed off

TAX ID # 309.28-5-2