


**Labor and Materials**

|     |                          |   |          |          |       |
|-----|--------------------------|---|----------|----------|-------|
| 1   | Copper Lead              | Connection  | 3/4"     | \$       | 2.60  |
| 1   | Curb                     | Cock Valve T-S & V.                                     | 3/4" in. | \$       | 2.27  |
| 1   | Service Box Old returned | Short 3/2 x 1/2<br>Long 4 1/2 x 5 1/2<br>Buff. or Rdway |          | \$       | 1.38  |
| 5   | Ft. 3/4" in.             | Copper Galv. Iron Cast Iron                             | Pipe at  | \$       | 9.0   |
|     | Nipples                  | in. at  |          | \$       |       |
|     | Bushings                 | to in. at   |          | \$       |       |
|     | Red'g Inc'g              | Couplings to in. at                                     |          | \$       |       |
|     | Union                    | in. at  |          | \$       |       |
|     | Meter                    | in. at  |          | \$       |       |
|     | Lbs. Br. Stone           | at  |          | \$       |       |
|     | Lbs. Sand                | at  |          | \$       |       |
|     | Bags Cement              | at  |          | \$       |       |
|     | Paving Brick             | Mack Red Asphalt  | at       | \$       |       |
|     | Lead Joints              | at  |          | \$       |       |
|     | Leadite Joints           | at  |          | \$       |       |
| 5   | Hrs. Foreman             | at  |          | \$       | 3.13  |
| 2   | Hrs. Common Labor        | Tapper  |          | \$       | 1.00  |
| 1.2 | Hrs. Common Labor        | at  |          | \$       | 5.40  |
|     | Hrs. Mason               | at  |          | \$       |       |
|     | Hrs. Mason's Helper      | at  |          | \$       |       |
| 1.4 | Hrs. Compressor          | at  |          | \$       | 1.50  |
|     | Compensation Ins         |   |          | \$       | 29    |
|     | Trucking                 |   |          | \$       | 1.00  |
|     | Builders' Use of Water   | Patel   |          | \$       | 23.00 |
|     |                          |   |          | Total \$ | 42.47 |

3/4" tap at 94 South st

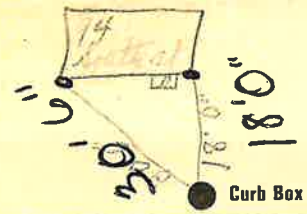

10" Main Elev of Main at tap 6ft  
 Gate at ● ● Gate at  
 5' to MAIN  
 3/4" copper  
 ● Curb Box

Old tap shut off  
 Shut off at Curb  
 July-17-1974