

Labor and Materials

| | | |
|-------|--|-----------------|
| 1 | Copper } Connection ^{3/4"} | \$ 2.60 |
| | Lead | |
| 1 | Curb } Cock | \$ 2.27 |
| | Valve | |
| | T.S. & V. } ^{3/4"} in. | |
| 1 | Service Box } Short ^{3 1/2 x 4 1/2} | \$ 1.38 |
| | Old returned } Long ^{4 1/2 x 5 1/2} | |
| | | Buff. or Rdway |
| 7 | Ft. ^{3/4"} in. } Copper | \$ 1.26 |
| | | Galv. Iron |
| | | Cast Iron |
| | Nipples | \$ |
| | Bushings | \$ |
| | Red'g } Couplings | \$ |
| | Inc'g } | \$ |
| | Union | \$ |
| | Meter | \$ |
| | Lbs. Br. Stone at | \$ |
| | Lbs. Sand at | \$ |
| | Bags Cement at | \$ |
| | Paving Brick } Mack | \$ |
| | | Red |
| | | Asphalt |
| | Lead Joints at | \$ |
| | Leadite Joints at | \$ |
| 5 | Hrs. Foreman at | \$ 3.13 |
| 2 | Hrs. Common Labor at ^{Tapper} | \$ 1.00 |
| 12 | Hrs. Common Labor at | \$ 5.40 |
| | Hrs. Mason at | \$ |
| | Hrs. Mason's Helper at | \$ |
| 1 1/4 | Hrs. Compressor at | \$ 1.50 |
| | Compensation Ins | \$ 2.90 |
| | Trucking | \$ 1.00 |
| | Builders Use of Water ^{Patch} | \$ 23.00 |
| | Total | \$ 42.83 |


31-110

96 SOUTH

Labor and Material Report

19 31

3/4 tap at 96 South of

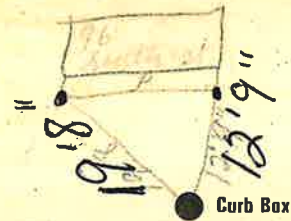

Main

Elev of Main at tap

Gate at

Gate at

7" to main
3/4" copper

Curb Box

Old tap shut off