

LABOR AND MATERIALS

1	Copper Lead	Connection	3/4"	\$
1	Curb Valve	Clock	3/4" in.	\$
Same	(T.S. & V.)			
	Service box	Short	3 1/2 X 4 1/2	\$
	Old returned	Long	4 1/2 X 5 1/2	\$
		Buff or Rdway		\$
8	Ft.	3/4" in.	Copper Galv. Iron Cast Iron	Pipe at \$
	Nipples	in. at		\$
	Bushings	to in. at		\$
	Red'g Inc'g	Couplings	to in. at	\$
	Union	in. at		\$
	Meter	in. at		\$
	Lead Joints	at		\$
	Compound Joints	at		\$
	Hrs. Foreman	at		\$
	Hrs. Chauffeur	at		\$
	Hrs. Tapper	at		\$
	Hrs. Labor	at		\$
	Hrs. Labor	at		\$
	Hrs. Compressor	at		\$
	Compensation Ins.			\$
	Trucking			\$
	Builders Use of Water			\$
	Tap by Gissard Co.			\$
	45-28-58			\$
				\$
				\$
				\$


98 SOUTH

St. Pl. Ave. No. 98

South

Name of Owner Louise Fosmett

Labor and Mat'l. Report May 28 1958

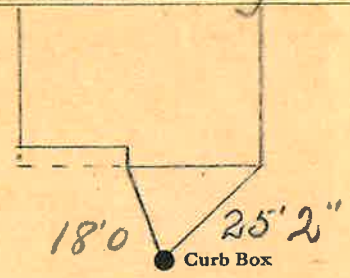

10" Main Elev. of Main at tap 6'

Gate at ● Gate at ●

slut off at curb
7-23-68

● Curb Box
To be razed
8' to main
3/4" copper