


**Labor and Materials**

Copper } Connection.....	$\frac{3}{4}$	\$ 2.70
Curb } Cock } .....	$\frac{3}{4}$	\$ 2.39
} Valve } .....		
} P. S. & V. } .....		
Service Box } Short $3\frac{1}{2} \times 1\frac{1}{2}$ } .....		\$ 1.45
Old returned } <del>Long</del> $4\frac{1}{2} \times 5\frac{1}{2}$ } .....		
} Buff-on-Railway } .....		
24 Ft. } in. } Copper } Pipe at.....	$\frac{3}{4}$	\$ 6.48
} in. } Galv. Iron } .....		
} in. } Cast Iron } .....		
Nipples.....	in. at.....	\$.....
Bushings.....	to..... in. at.....	\$.....
Red'g } Couplings.....	to..... in. at.....	\$.....
Inc'g } .....		
Union.....	in. at.....	\$.....
Meter.....	in. at.....	\$.....
Lbs. Br. Stone at.....		\$.....
Lbs. Sand at.....		\$.....
Bags Cement at.....		\$.....
Paving Brick } Mack } at.....		\$.....
} Red } .....		
} Asphalt } .....		
Lead Joints at.....		\$.....
Leadite Joints at.....		\$.....
4 Hrs. Foreman at.....		\$ 7.50
16 Hrs. Common Labor at.....		\$ 7.20
Hrs. Common Labor at.....		\$.....
Hrs. Mason at.....		\$.....
Hrs. Mason's Helper at.....		\$.....
7 Hrs. Compressor at.....	1.50	\$ 3.-
Compensation Ins.....		\$ .30
Trucking.....		\$ 1.-
Builders' Use of Water.....	Patch	\$ 3.-
Total \$		50.02

**Labor and Material Report**

30-157  
 99-101 SOUTH  
 12193  
 99-101 South St

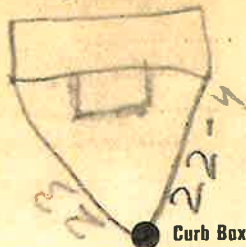

10 Main Elev of Main at tap 42

Gate at Gate at

24' to main  
 3/4" copper

Curb Box

Old tap disconnected

TAX ID# 309.28.9-1