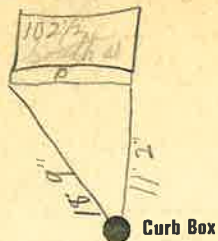


31-113

Labor and Material Report

1931

3/4 tap at 102<sup>A</sup> South at (Brown)

10" Main

Elev of Main at tap 6.4'

Gate at

Gate at

● Curb Box

New tap

Shut off at Curb

July-17-1974

31-112

102 SOUTH

Labor and Material Report

1931

3/4 tap at 102 South at ~~BL~~

10" Main

Elev of Main at tap 6.4'

Gate at

Gate at

8' to main  
3/4" copper

● Curb Box

Old tap shut off

City of GF

TAX ID# 309.36-1-1

Shut off at Curb  
July-29-1974

702-H South 51



Dec 19-57

### Labor and Materials

1	Copper Lead	Connection	3/4"	\$	2.60
1	Curb	Cock Valve T-S & V.	3/4" in.	\$	2.27
1	Service Box Old returned	Short 3/4x4 1/2 Long 4 1/2x5 1/2 Buff. or Rdway		\$	1.59
6	Ft. 3/4" in.	Copper Galv. Iron Cast Iron	Pipe at	\$	1.08
	Nipples	in. at		\$	
	Bushings	to in. at		\$	
	Red'g Inc'g	Couplings	to in. at	\$	
	Union	in. at		\$	
	Meter	in. at		\$	
	Lbs. Br. Stone	at		\$	
	Lbs. Sand	at		\$	
	Bags Cement	at		\$	
	Paving Brick	Mack Red Asphalt	at	\$	
	Lead Joints	at		\$	
	Leadite Joints	at		\$	
5	Hrs. Foreman			\$	3.13
2	Hrs. Common Labor	Tapper		\$	1.00
12	Hrs. Common Labor			\$	5.40
	Hrs. Mason	at		\$	
	Hrs. Mason's Helper	at		\$	
1 1/2	Hrs. Compressor	at		\$	1.50
	Compensation Ins			\$	.29
	Trucking			\$	1.00
	Builders' Use of Water	Patch		\$	.23
				Total \$	42.86

### Labor and Materials

1	Copper Lead	Connection	3/4"	\$	2.60
1	Curb	Cock Valve T-S & V.	3/4" in.	\$	2.27
1	Service Box Old returned	Short 3/4x4 1/2 Long 4 1/2x5 1/2 Buff. or Rdway		\$	1.38
8	Ft. 3/4" in.	Copper Galv. Iron Cast Iron	Pipe at	\$	1.44
	Nipples	in. at		\$	
1	Bushings	3/4" to 1/2" in. at		\$	1.10
	Red'g Inc'g	Couplings	to in. at	\$	
	Union	in. at		\$	
	Meter	in. at		\$	
	Lbs. Br. Stone	at		\$	
	Lbs. Sand	at		\$	
	Bags Cement	at		\$	
	Paving Brick	Mack Red Asphalt	at	\$	
	Lead Joints	at		\$	
	Leadite Joints	at		\$	
5	Hrs. Foreman			\$	3.13
2	Hrs. Common Labor	Tapper		\$	1.00
12	Hrs. Common Labor			\$	5.40
	Hrs. Mason	at		\$	
	Hrs. Mason's Helper	at		\$	
1 1/2	Hrs. Compressor	at		\$	1.50
	Compensation Ins			\$	.29
	Trucking			\$	1.00
	Builders' Use of Water	Patch		\$	.23
				Total \$	43.11