

### Labor and Materials



1	Copper Lead	Connection	3/4"	\$ 2.60
1	Curb	Cock Valve T.S. & V.	3/4" in.	\$ 2.27
1	Service Box Old returned	Short 3/4x1 1/2 Long 1 1/2x5 1/2 Buil. or Rdway		\$ 1.59
5	Ft.	Copper Galv. Iron Cast-Iron	Pipe at 2 1/2 in.	\$ 1.44
	Nipples		in. at	\$
	Bushings		to in. at	\$
	Red'g Inc'g	Couplings	to in. at	\$
	Union		in. at	\$
	Meter		in. at	\$
	Lbs. Br. Stone		at	\$
	Lbs. Sand		at	\$
	Bags Cement		at	\$
	Paving Brick	Mack Red Asphalt	at	\$
	Lead Joints		at	\$
	Leadite Joints		at	\$
5	Hrs. Foreman		at	\$ 3.13
2	Hrs. Common Labor	Tapper		\$ 1.00
12	Hrs. Common Labor		at	\$ 5.40
	Hrs. Mason		at	\$
	Hrs. Mason's Helper		at	\$
1 1/2	Hrs. Compressor		at	\$ 1.50
	Compensation Ins.			\$ .29
	Trucking			\$ 1.00
	Builders' Use of Water	Patch		\$ 73.00
Total				\$ 43.22

### Labor and Material Report

1937

31-112 SOUTH

3/4 Tap at 112 South

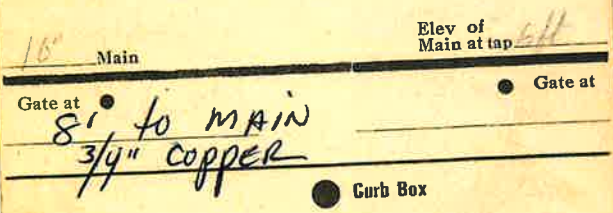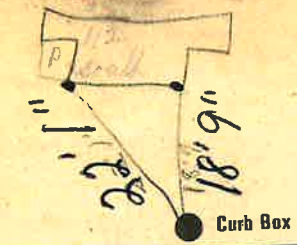

New tap  
Shut off at Curb  
Aug. 15-1974