


Labor and Materials


1	Copper	Connection	3/4"	\$ 2.60
	Lead			
1	Curb	Cock Valve	3/4" in.	\$ 2.27
		T.S. & V.		
1	Service Box	Short	3 1/2 x 4 1/2	\$ 1.59
9	Old returned	Long	4 1/2 x 5 1/2	
		Buff. or Rdway		
6	Pt.	Copper	3/4" in.	\$ 1.44
		Galv. Iron		
		Cast Iron	Pipe at	
	Nipples		in. at	\$
	Bushings		to in. at	\$
	Red'g	Couplings	to in. at	\$
	Inc'g			
	Union		in. at	\$
	Meter		in. at	\$
	Lbs. Br. Stone	at		\$
	Lbs. Sand	at		\$
	Bags Cement	'at		\$
	Paving Brick	Mack	at	\$
		Red		
		Asphalt		
	Lead Joints	at		\$
	Leadite Joints	at		\$
5	Hrs. Foreman	at		\$ 3.13
2	Hrs. Common Labor	Tapper		\$ 1.00
1.7	Hrs. Common Labor	at		\$ 5.40
	Hrs. Mason	at		\$
	Hrs. Mason's Helper	at		\$
1 1/2	Hrs. Compressor	at		\$ 1.50
	Compensation Ins			\$.29
	Trucking			\$ 1.00
	Builders' Use of Water			\$ 23.00
Total \$				43.22

31-119 **114 SOUTH**
Labor and Material Report July 13 1931

3/4" Tap 114 South St.

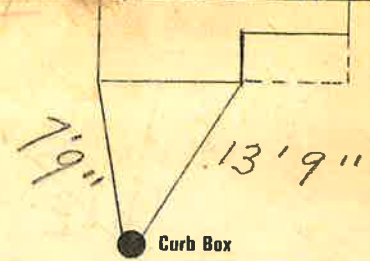

10" Main Elev of Main at tap 6.11

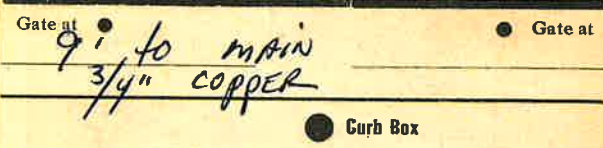

Old tap shut off

Curb box set back
 from road in 1964
 Shut off at Curb
 8-15-1974