


Labor and Materials

1	Copper } Connection	3/4	\$ 2.60
	Lead		
1	Curb } Cock Valve	3/4 in.	\$ 2.27
		T. S. & V.	
1	Service Box } Short 3/4x1/2		\$ 1.59
	Old returned } Long 4/2x5/2		
		Buff. or Rdway	
46	Ft. 3/4 in. } Copper Galv. Iron Pipe at		\$ 1.44
		Cast Iron	
	Nipples	in. at	\$
	Bushings	to in. at	\$
	Red'g Inc'g } Couplings	to in. at	\$
	Union	in. at	\$
	Meter	in. at	\$
	Lbs. Br. Stone	at	\$
	Lbs. Sand	at	\$
	Bags Cement	at	\$
	Paving Brick } Mack Red Asphalt	at	\$
	Lead Joints	at	\$
	Leadite Joints	at	\$
5	Hrs. Foreman	at	\$ 3.13
2	Hrs. Common Labor	at Tapper	\$ 1.00
12	Hrs. Common Labor	at	\$ 5.40
	Hrs. Mason	at	\$
	Hrs. Mason's Helper	at	\$
1 1/2	Hrs. Compressor	at	\$ 1.50
	Compensation Ins		\$ .29
	Trucking		\$ 1.00
	Builders' Use of Water	at	\$ 23.00
	Total		\$ 43.72

31-172 124 SOUTH July 14 1931

3/4 tap at 126 South St. (bright)

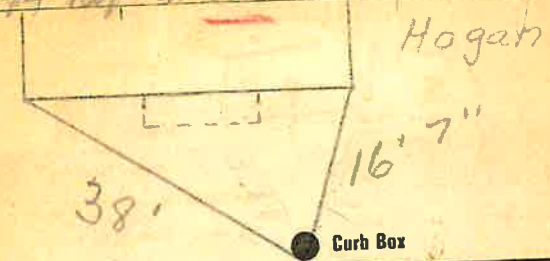

10" Main Elev of Main at tap 4.11

Gate at 11" to MAIN 3/4" copper Gate at

Curb Box

Old tap shut off

122-128 TAX ID

# 309.36-2-13