


Labor and Materials

1	Copper } Connection $3/4$	\$ 2.60
	Lead	
1	Curb { Cock Valve } $3/4$ in.	\$ 2.27
	{ T.S. & V. }	
19	Service Box { Short $3/4 \times 4 1/2$ }	\$ 1.38
	Old returned { Long $4 1/2 \times 5 1/2$ }	
	{ Buff. or Rdway }	
8	Ft. $3/4$ in. { Copper Galv. Iron } Pipe at.	\$ 1.44
	{ Cast-Iron }	
	Nipples..... in. at.....	\$
	Bushings..... to..... in. at.....	\$
	Red'g } Couplings..... to..... in. at.....	\$
	Inc'g }	
	Union..... in. at.....	\$
	Meter..... in. at.....	\$
	Lbs. Br. Stone at.....	\$
	Lbs. Sand at.....	\$
	Bags Cement at.....	\$
	Paving Brick { Mack Red Asphalt } at.....	\$
	Lead Joints at.....	\$
	Leadite Joints at.....	\$
5	Hrs. Foreman at.....	\$ 2.13
2	Hrs. Common Labor at..... Tapper	\$ 1.00
1.7	Hrs. Common Labor at.....	\$ 5.40
	Hrs Mason at.....	\$
	Hrs Mason's Helper at.....	\$
1.4	Hrs. Compressor at.....	\$ 1.50
	Compensation Ins.....	\$.29
	Trucking.....	\$ 1.00
	Builders' Use of Water Patch.....	\$ 23.00

Curb set back Total \$ 43.01
 11' - 1962.

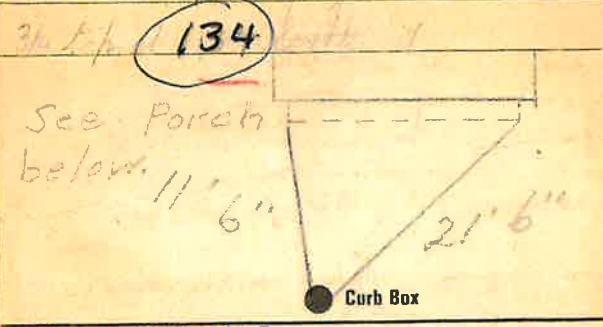

TAX ID# 309.36-2-15
 10' Main MAIN $3/4$ " Elev of Main at tap 6.15
 Gate at MAIN of 61 Gate at

