


Labor and Materials

1	Copper } Connection 3/4"	\$ 2.60	
	Lead		
1	Curb } Cock Valve } 3/4" in.	\$ 2.27	
	T.S. & V.		
1	Service Box } Short 3/4 x 4/8	\$ 1.38	
	Old returned } Long 4 1/2 x 5 1/2		
		Bull. or Rdway	
9	Ft. 3/4" in. } Copper Galv. Iron } Pipe at	\$ 1.44	
		Cast Iron	
	Nipples	in. at \$	
1	Bushings 3/4" to 1/2" in. at	\$.10	
	Red g } Couplings	to in. at \$	
	Inc'g		
	Union	in. at \$	
	Meter	in. at \$	
	Lbs. Br. Stone at	\$	
	Lbs. Sand at	\$	
	Bags Cement 'at	\$	
	Paving Brick } Mack } at	\$	
			Red
			Asphalt
	Lead Joints at	\$	
	Leadite Joints at	\$	
5	Hrs. Foreman at	\$ 3.13	
2	Hrs. Common Labor at Tapper	\$ 1.00	
17	Hrs. Common Labor at	\$ 5.40	
	Hrs. Mason at	\$	
	Hrs. Mason's Helper at	\$	
	Hrs. Compressor at	\$	
1 1/2	Compensation Ins	\$ 1.50	
	Trucking	\$ 1.00	
	Builders' Use of Water Patch	\$ 78.00	
Total \$		43.11	

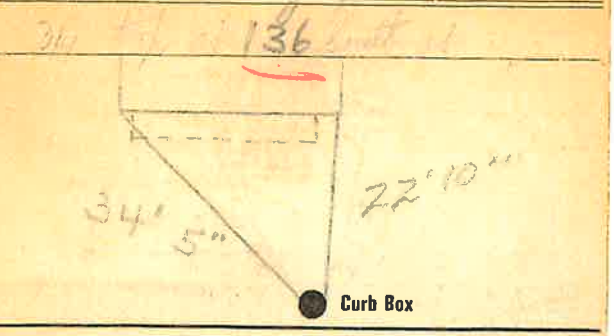

10 Main Elev of Main at tap 6.64
 Gate at 8' to MAIN Gate at
 3/4" COPPER
 Curb Box

Old tap shut off
 cut in new curb
 stop 8-22-62
 on their pipe
 TAX ID # 309.36-2-16