


Labor and Materials

1	Copper } Connection 3/4"	\$ 2.60
1	Lead } Curb { Cock Valve } P.S. & V. { 3/4" in.	\$ 2.27
1	Service Box } Short 3/4x4 1/2" } Old returned } Long 1 1/2x5 1/2" } Buff. or Rdway }	\$ 1.38
24	22 Ft. 3/4" in. Copper Galy. Iron Pipe at Cast Iron	\$ 3.96
	Nipples..... in. at.....	\$
	Bushings..... to..... in. at.....	\$
	Red'g } Inc'g } Couplings..... to..... in. at.....	\$
	Union..... in. at.....	\$
	Meter..... in. at.....	\$
	Lbs. Br. Stone at.....	\$
	Lbs. Sand at.....	\$
	Bags Cement 'at.....	\$
	Paving Brick { Mack } { Red } { Asphalt } at.....	\$
	Lead Joints at.....	\$
	Leadite Joints at.....	\$
5	Hrs. Foreman at.....	\$ 3.13
2	Hrs. Common Labor at Tapper	\$ 1.00
17	Hrs. Common Labor at.....	\$ 5.40
	Hrs Mason at.....	\$
	Hrs Mason's Helper at.....	\$
1 1/2	Hrs. Compressor at.....	\$ 1.50
	Compensation Ins.....	\$.29
	Trucking.....	\$ 1.00
	Builders' Use of Water <i>Watch</i>	\$ 2.00
	Total	\$ 15.53

31-129 137 SOUTH
 Labor and Material Report July 15 1931

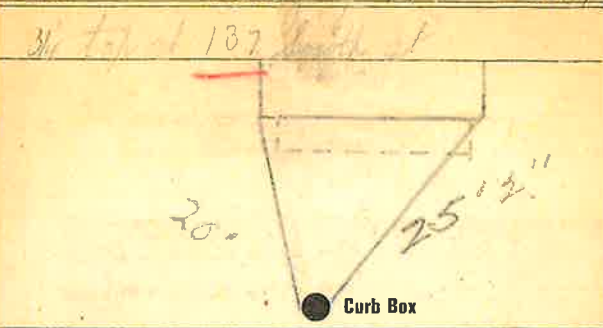

10' Main Elev of Main at tap 6.11
 Gate at ● ● Gate at
 24' to main
 3/4" copper
 ● Curb Box

Old tap shut off
Curb box set back
2' - 1962
 TAX ID# 309.35.53