

Labor and Materials

1	Copper	Connection	3/4"	\$ 7.60
	Lead			
1	Curb	Cock Valve	3/4" in.	\$ 2.27
		F.S. & V.		
1	Service Box	Short	3/4" x 1 1/2"	\$ 1.38
10	Old returned	Long	4 1/2" x 5 1/2"	
		Buff. or Rdway		
8	Ft.	3/4" in.	Copper Galv. Iron Pipe at	\$ 1.44
			Cast Iron	
	Nipples		in. at	\$
1	Bushings	3/8" to 1/2"	in. at	\$ 1.0
	Red'g Inc'g	Couplings	to in. at	\$
	Union		in. at	\$
	Meter		in. at	\$
	Lbs. Br. Stone		at	\$
	Lbs. Sand		at	\$
	Bags Cement		at	\$
	Paving Brick	Mack Red Asphalt	at	\$
	Lead Joints		at	\$
	Leadite Joints		at	\$
5	Hrs. Foreman		at	\$ 3.13
2	Hrs. Common Labor	Tapper	at	\$ 1.00
17	Hrs. Common Labor		at	\$ 5.40
	Hrs. Mason		at	\$
	Hrs. Mason's Helper		at	\$
1 1/2	Hrs. Compressor		at	\$ 1.50
	Compensation Ins.		at	\$ 2.9
	Trucking		at	\$ 1.00
	Builders' Use of Water	patch	at	\$ 23.00


Total \$ 43.11

31-130 138 SOUTH

Labor and Material Report

1921

The top of 138

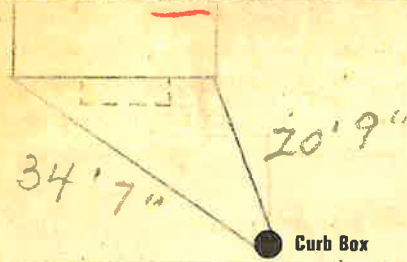

10' Main

Elev of Main at tap 61.7

Gate at

10' to MAIN
3/4" copper

Gate at

Curb Box

Old tap shut off

TAX ID# 309.36-2-18