

### Labor and Materials

1	Copper	Connection	3/4"	\$ 2.60
1	Lead			
1	Curb	Cock Valve T.S. & V.	3/4" in.	\$ 2.27
1	Service Box	Short 3/4" x 1/2"		\$ 1.38
	Old returned	Long 4 1/2" x 3/4"	Buff. or Rdway	
2.2	Ft. 3/4" in.	Copper Galv. Iron Cast-iron	Pipe at	\$ 3.96
	Nipples	in. at		\$
	Bushings	to in. at		\$
	Red'g Inc'g	Couplings	to in. at	\$
	Union	in. at		\$
	Meter	in. at		\$
	Lbs. Br. Stone	at		\$
	Lbs. Sand	at		\$
	Bags Cement	at		\$
	Paving Brick	Mack Red Asphalt	at	\$
	Lead Joints	at		\$
	Leadite Joints	at		\$
5	Hrs. Foreman	at		\$ 8.13
7	Hrs. Common Labor	at Tapper		\$ 1-
12	Hrs. Common Labor	at		\$ 5.40
	Hrs. Mason	at		\$
	Hrs. Mason's Helper	at		\$
14 1/2	Hrs. Compressor	at		\$ 1.50
	Compensation Ins			\$ 29
	Trucking			\$ 1-
	Builders' Use of Water			\$ 23-
Total \$				45.53


31-134

145 SOUTH

Labor and Material Report

19 71

3/4" top at 145 South St

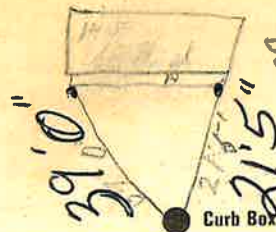

HOUSES TO BE RATED

6" Main

Elev of Main at tap 4/2H

Gate at

Gate at

22' to MAIN  
3/4" COPPER

Curb Box

Old tap shut off

Shut off at Curb

12-5-1972