



**Labor and Materials**

1	Copper	Connection	3/4	\$	2.60
1	Curb	Cock Valve	3/4 in.	\$	2.27
1	Service Box	Short	3/4 x 1 1/2	\$	1.38
	Old returned	Long	1 1/2 x 3/4		
		Buff. or Rd-way			
27	Ft.	3/4 in.	Copper Galv. Iron Pipe at	\$	4.86
	Nipples	in. at	Cast-Iron	\$	
	Bushings	to in. at		\$	
	Red'g Inc'g	Couplings to in. at		\$	
	Union	in. at		\$	
	Meter	in. at		\$	
	Lbs. Br. Stone	at		\$	
	Lbs. Sand	at		\$	
	Bags Cement	at		\$	
	Paving Brick	Mack Red Asphalt at		\$	
	Lead Joints	at		\$	
	Leadite Joints	at		\$	
5	Hrs. Foreman	at		\$	3.13
2	Hrs. Common Labor	at	Tapper	\$	1.00
12	Hrs. Common Labor	at		\$	5.40
	Hrs. Mason	at		\$	
	Hrs. Mason's Helper	at		\$	
1 1/2	Hrs. Compressor	at		\$	1.50
	Compensation Ins.			\$	.79
	Trucking			\$	1.00
	Builders' Use of Water		Patrol	\$	23.00
				Total \$	46.43

3/4" Tap at 147 South of

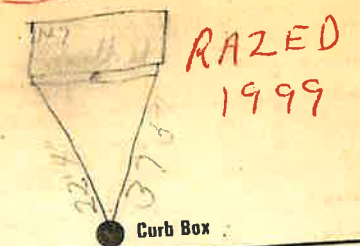

RAZED  
1999

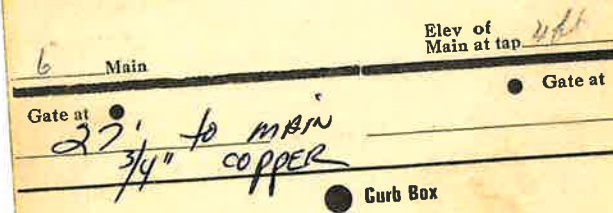

Old tap shut off

TAX ID# 309.12-2-2