


LABOR AND MATERIALS

Copper	}	Connection		\$	
Lead					
Curb	}	Cock	in.	\$	
		Valve			
		T.S. & V.			
Service box	{	Short 3-1/2 x 4-1/2	}	\$	
Old returned		Long 4-1/2 x 5-1/2			
Ft. _____ in.	{	Copper	} Pipe at	\$	
		G.I.			
		C.I.			
Nipples _____ in.		at _____		\$	
Bushings _____ to _____ in.		at _____		\$	
Red'g _____				\$	
Inc'g _____				\$	
Union _____ in.		at _____		\$	
Meter _____ in.		at _____		\$	
_____				\$	
Compound Joints at _____				\$	
Maintenance Foreman _____				\$	
Hrs. Water Maint. Man - 1 at _____				\$	
Hrs. Water Maint. Man - 2 at _____				\$	
Hrs. Garage Foreman _____ at _____				\$	
Hrs. Labor _____ at _____				\$	
Hrs. Compressor at _____				\$	
_____				\$	
Trucking _____				\$	
Pav't Patch _____				\$	
_____				\$	
_____				\$	
St. _____
 Pl. _____
 Ave. No. 154

Name of Owner _____
SOUTH
 TAX ID # 309.12.11-14

Labor and Mat'l. Report 19

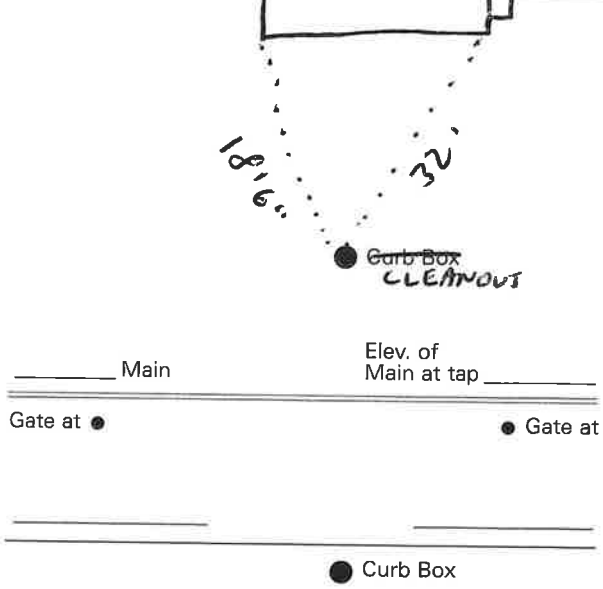

Labor and Material Report

Oct 9 1923

1/2" top of 108 South of (154)



Curb Box

Main

Elev. of
Main at tap

Gate at

7' to main

Gate at

3/4" copper

Curb Box

Labor and Material Report

Oct 18-22 1923

Concrete Hole at 108 South
Patching Mason ST

Curb Box

Main

Elev. of
Main at tap

Gate at

Gate at

Curb Box

Labor and Materials

Lead Connection	\$
Curb Cock	\$
Service Box (Short 3½ x 4½)	\$
Old returned (Long 4½ x 5½)	\$
Buffalo	\$
7 Ft. 3½" in. G. I. Pipe at	\$
Nipples	\$
Bushings	\$
Red'g Coup	\$
Inc'g Coup	\$
Union	\$
Meter	\$
Cu. Yds. Br. Stone at	\$
Cu. Yds. Sand at	\$
Bags Cement at	\$
Paving Brick { Mack Red Asphalt } at	\$
5 Hrs. Foreman at	\$
1.4 Hrs. Common Labor at	\$
Hrs. Mason at	\$
Hrs. at	\$
Hrs. at	\$
9.5 Builders' Use of Water	\$
at	\$
Truck 1.00	\$
at	\$
at	\$
at	\$
Total	\$

Labor and Materials

Lead Connection	\$
Curb Cock	\$
Service Box (Short 3½ x 4½)	\$
Old returned (Long 4½ x 5½)	\$
Buffalo	\$
Ft. in. G. I. Pipe at	\$
Nipples	\$
Bushings	\$
Red'g Coup	\$
Inc'g Coup	\$
Union	\$
Meter	\$
6.00 Cu. Yds. Br. Stone at	\$
4.00 Cu. Yds. Sand at	\$
1½ Bags Cement at	\$
4.0 Paving Brick { Mack Red Asphalt } at	\$
2 Hrs. Foreman at	\$
2 Hrs. Common Labor at	\$
7 Hrs. Mason at	\$
9 Hrs. at	\$
Hrs. at	\$
Builders' Use of Water	\$
at	\$
Truck 1.00	\$
at	\$
at	\$
at	\$
Total	\$ 29.57