

LABOR AND MATERIALS


1 Copper } Connection <sup>3/4"</sup> \$ \_\_\_\_\_  
 1 Lead }  
 1 Curb } Cock } 3/4 in. \$ \_\_\_\_\_  
 } Valve }  
 } T.S. & V. }  
 1 Service box { Short 3 1/2 x 4 1/2 }  
 Old returned { Long 4 1/2 x 5 1/2 }  
 { Buff or Rdway } \$ \_\_\_\_\_  
 9 Ft. <sup>3/4</sup> in. { Copper } Pipe at \$ \_\_\_\_\_  
 } G. I. }  
 } C. I. }  
 Nipples \_\_\_\_\_ in. at \$ \_\_\_\_\_  
 Bushings \_\_\_\_\_ to \_\_\_\_\_ in. at \$ \_\_\_\_\_  
 Red'g }  
 Inc'g } Coupl'gs. \_\_\_\_\_ to \_\_\_\_\_ in. at \$ \_\_\_\_\_  
 Union \_\_\_\_\_ in. at \$ \_\_\_\_\_  
 Meter \_\_\_\_\_ in. at \$ \_\_\_\_\_  
 Lead Joints at \$ \_\_\_\_\_  
 Compound Joints at \$ \_\_\_\_\_  
 Maintenance Foreman \$ \_\_\_\_\_  
 Hrs. Water Maint. Man-1 at \$ \_\_\_\_\_  
 Hrs. Water Maint. Man-2 at \$ \_\_\_\_\_  
 Hrs. Garage Foreman \_\_\_\_\_ at \$ \_\_\_\_\_  
 Hrs. Labor \_\_\_\_\_ at \$ \_\_\_\_\_  
 Hrs. Compressor at \$ \_\_\_\_\_  
 Compensation Ins. at \$ \_\_\_\_\_ per C \$ \_\_\_\_\_  
 Trucking \$ \_\_\_\_\_  
 Pav't Patch \$ \_\_\_\_\_  
 Tap by Gissard & Co. \$ \_\_\_\_\_  
 7-30-62 \$ \_\_\_\_\_  
 O'head \$ \_\_\_\_\_  
 \$ \_\_\_\_\_

156 SOUTH

St. \_\_\_\_\_  
 -Pt. \_\_\_\_\_  
 Ave. No. 156

Name of Owner  
 Walter Scavincio

Labor and Mat'l. Report July 30 1962

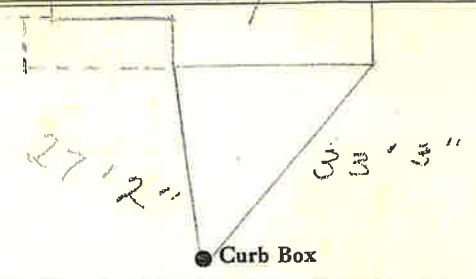

6" C.I. Main Elev. of Main at tap 5'

Gate at • Gate at  
 9' to main

3/4" Copper • Curb Box

TAX ID# 309.12.11.15