

LABOR AND MATERIALS

1	Copper	{ Connection	10" x 6" TS	\$	
1	Lead			\$	
1	Curb	{ Curb Valve T.S. & V. }	6" in.	\$	
1	Service box	{ Short 3 1/2 x 4 1/2	with Extension	\$	
	Old returned	{ Long 4 1/2 x 5 1/2			
9	Ft. 6 in.	{ Copper G.I. C.I. }	Pipe at	\$	
	Nipples	in. at		\$	
	Bushings	to in. at		\$	
	Red'g Inc'g	{ Coupl'gs to in. at		\$	
	Union	in. at		\$	
2 1/2"	Meter	Jute in. at		\$	
53"	Lead Joints	at		\$	
10"	Compound Joints	at		\$	
	Hrs. Water Maint. Man	1 at		\$	
32	Hrs. Water Maint. Man	2 at 1.02		\$ 32.64	
47	Hrs. Labor	at		\$ 43.77	
5	Hrs. Labor	Mech 1.145	91	\$ 5.73	
2	Hrs. Compressor	at 1.20		\$ 2.40	
	Compensation Ins. at \$	per C.		\$ 1.81	
	Trucking			\$	
	Pav't Patch			\$ 16.80	
	Tap by Bureau			\$	
	O'head			\$	


118

✓  
South

St. ~~Pl.~~  
Ave. No. 22 ✓

Name of Owner  
Hotel Madden

Labor and Mat'l. Report Sept. 13 19 50

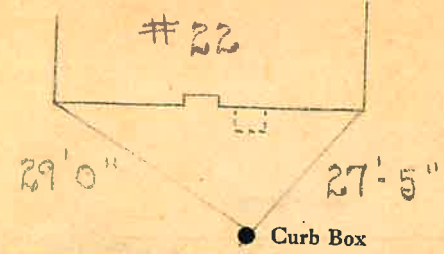

10" Main Elev. of Main at tap 7'

Gate at • Gate at

9 1/2' to main

• Curb Box  
6" Tap.  
#20 - #24 - part of Bank