


SOUTH

St. 157
Pl. ~~157~~
Ave. No.

Name of Owner

Tax ID # 309.12-9-7

Labor and Mat'l. Report 19

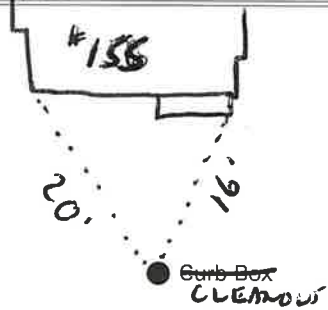

_____ Main

Elev. of Main at tap _____

Gate at ●

● Gate at

● Curb Box


31-136 - 157 SOUTH

Labor and Material Report

July 10

1931

3/4 tap at 107 South st

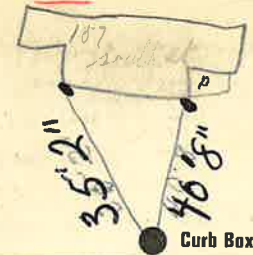

6" Main

Elev of Main at tap 4ft

Gate at ●

● Gate at

26' to main
3/4" COPPER

● Curb Box

Old tap shut off

LABOR AND MATERIALS

Copper	Lead	} Connection		\$	
_____	_____	_____	_____	_____	_____
Curb	Cock Valve T.S. & V.	} _____ in.		\$	
_____	_____	_____	_____	_____	_____
Service box	Old returned	{ Short 3-1/2 x 4-1/2 Long 4-1/2 x 5-1/2 }		\$	
_____	_____	_____	_____	_____	_____
Ft.	in.	{ Copper G.I. C.I. }	Pipe at	\$	
_____	_____	_____	_____	_____	_____
Nipples		_____ in.	at	\$	
_____		_____	_____	_____	_____
Bushings		_____ to _____ in.	at	\$	
_____		_____	_____	_____	_____
Red'g					

Inc'g					

Union		_____ in.	at	\$	
_____		_____	_____	_____	_____
Meter		_____ in.	at	\$	
_____		_____	_____	_____	_____
				\$	
Compound Joints		at		\$	
_____		_____		_____	_____
Maintenance Foreman				\$	
_____				_____	_____
Hrs. Water Maint. Man - 1		at		\$	
_____		_____		_____	_____
Hrs. Water Maint. Man - 2		at		\$	
_____		_____		_____	_____
Hrs. Garage Foreman		at		\$	
_____		_____		_____	_____
Hrs. Labor		at		\$	
_____		_____		_____	_____
Hrs. Compressor		at		\$	
_____		_____		_____	_____
				\$	
Trucking				\$	
_____				_____	_____
Pav't Patch				\$	
_____				_____	_____
				\$	
				\$	
Labor and Materials					
1	Copper	Lead	} Connection ^{3/4"}		\$ 2.60
_____	_____	_____	_____	_____	_____
1	Curb	Cock Valve T.S. & V.	} _____ in. ^{3/4"}		\$ 2.27
_____	_____	_____	_____	_____	_____
1	Service Box	Old returned	{ Short 3 1/2 x 4 1/2 Long 4 1/2 x 5 1/2 Buff. or Rdway }		\$ 1.35
_____	_____	_____	_____	_____	_____
26	Ft.	3/4" in.	{ Copper Galv. Iron Cast Iron }	Pipe at	\$ 4.68
_____	_____	_____	_____	_____	_____
	Nipples		_____ in.	at	\$
_____	_____	_____	_____	_____	_____
	Bushings		_____ to _____ in.	at	\$
_____	_____	_____	_____	_____	_____
	Red'g				\$
_____	_____	_____	_____	_____	_____
	Inc'g				\$
_____	_____	_____	_____	_____	_____
	Union		_____ in.	at	\$
_____	_____	_____	_____	_____	_____
	Meter		_____ in.	at	\$
_____	_____	_____	_____	_____	_____
					\$
	Lbs. Br. Stone		at		\$
_____	_____	_____	_____	_____	_____
	Lbs. Sand		at		\$
_____	_____	_____	_____	_____	_____
	Bags Cement		at		\$
_____	_____	_____	_____	_____	_____
	Paving Brick		{ Mack Red Asphalt }	at	\$
_____	_____	_____	_____	_____	_____
	Lead Joints		at		\$
_____	_____	_____	_____	_____	_____
	Leadite Joints		at		\$
_____	_____	_____	_____	_____	_____
5	Hrs. Foreman		at		\$ 3.13
_____	_____	_____	_____	_____	_____
2	Hrs. Common Labor		at ^{Tapper}		\$ 1.00
_____	_____	_____	_____	_____	_____
1.2	Hrs. Common Labor		at		\$ 5.40
_____	_____	_____	_____	_____	_____
	Hrs. Mason		at		\$
_____	_____	_____	_____	_____	_____
	Hrs. Mason's Helper		at		\$
_____	_____	_____	_____	_____	_____
1 1/2	Hrs. Compressor		at		\$ 1.50
_____	_____	_____	_____	_____	_____
	Compensation Ins.				\$ 29
_____	_____	_____	_____	_____	_____
	Trucking				\$ 1.00
_____	_____	_____	_____	_____	_____
	Builders' Use of Water		^{Patch}		\$ 23.00
_____	_____	_____	_____	_____	_____
Total \$					46.75