
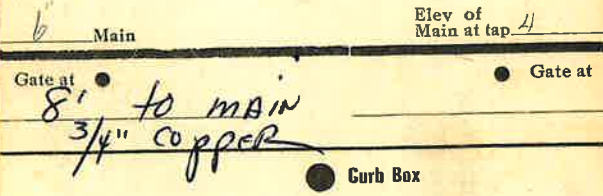


**Labor and Materials**

1	Copper	Lead	Connection	3/4"	\$ 2.60
1	Curb	Cock Valve	P.S. & V.	3/4" in.	\$ 2.27
1	Service Box	Old returned	Short 3 1/2 x 1 1/2 Long 4 1/2 x 5 1/2 Buff. or Rdway		\$ 1.38
8	Ft.	3/4" in.	Copper Galv. Iron Cast Iron	Pipe at	\$ 1.44
	Nipples		in. at		\$
	Bushings		to in. at		\$
	Red'g Inc'g	Couplings	to in. at		\$
	Union		in. at		\$
	Meter		in. at		\$
	Lbs. Br. Stone	at			\$
	Lbs. Sand	at			\$
	Bags Cement	at			\$
	Paving Brick	Mack Red Asphalt	at		\$
	Lead Joints	at			\$
	Leadite Joints	at			\$
5	Hrs. Foreman	at			\$ 3.13
2	Hrs. Common Labor	at	Tapper		\$ 1.00
12	Hrs. Common Labor	at			\$ 5.40
	Hrs. Mason	at			\$
	Hrs. Mason's Helper	at			\$
1 1/2	Hrs. Compressor	at			\$ 1.50
	Compensation Ins.				\$ 29
	Trucking				\$ 1.00
	Builders' Use of Water	Patch			\$ 25.00
Total \$					43.01

31-137 **158**  
 Labor and Material Report July 15 1931

3/4" tap at 159 South St

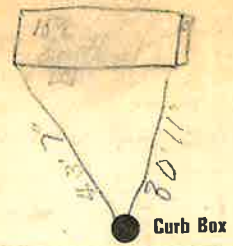

Old tap shut off

TAX ID # 309.12-11.16