

LABOR AND MATERIALS

1	Copper Lead	Connection	3/4"	\$	2.41
1	Curb	Cock Valve T.S. & V.	3/4 in.	\$	3.41
1	Service box	Short 3 1/2 x 4 1/2		\$	4.18
	Old returned	Long 4 1/2 x 5 1/2		\$	
		Buff or Rdway		\$	
23	Ft. 3/4 in.	Copper Pipe at	40	\$	9.20
		G.I.		\$	
		C.I.		\$	
	Nipples	in. at		\$	
	Bushings	to in. at		\$	
	Red'g	Coupl'gs to in. at		\$	
	Inc'g			\$	
	Union	in. at		\$	
	Meter	in. at		\$	
	Lead Joints	at		\$	
	Compound Joints	at		\$	
	Maintenance Foreman			\$	
8	Hrs. Water Maint. Man-1	at		\$	
	Hrs. Water Maint. Man-2	at 1.24		\$	9.92
	Hrs. Garage Foreman	at		\$	
25	Hrs. Labor	at 1.13		\$	28.25
	Hrs. Compressor	at		\$	
	Compensation Ins. at \$	38.61 per C.		\$	1.47
	Trucking			\$	1.50
	Pav't Patch			\$	11.25
	Tap by GISSO	rd/6-4-54		\$	
	O'head			\$	
				\$	71.59

W 34

165 SOUTH


South

St. Pl. Ave. No. 165

Name of Owner

Bush

Labor and Mat'l. Report JUNE 4 19 54

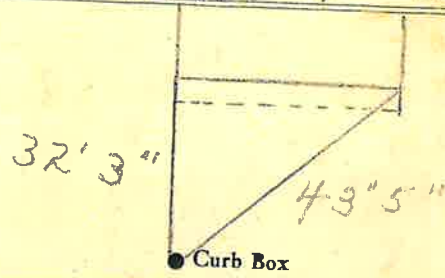

6" Main Elev. of Main at tap 5'

Gate at • Gate at

23' to main

3/4" copper • Curb Box

TAX ID # 309.12-9-4