


Labor and Materials

1	Copper	Connection	3/4"	\$ 2.60
1	Lead			
1	Curb	Cock Valve	3/4" in.	\$ 2.27
		T.S. & V.		
1	Service Box	Short 3/4"x4 1/2"		\$ 1.38
	Old returned	Long 1 1/2"x5 1/2"		
		Buff. or Rdway		
8	Ft.	3/4" in.	Copper Galv. Iron Pipe at	\$ 1.44
			Cast Iron	
	Nipples		in. at	\$
1	Bushings	3/4" to 1/2" in.	at	\$ 1.0
	Red'g Inc'g	Couplings	to in. at	\$
	Union		in. at	\$
	Meter		in. at	\$
	Lbs. Br. Stone		at	\$
	Lbs. Sand		at	\$
	Bags Cement		at	\$
	Paving Brick	Mack Red Asphalt	at	\$
	Lead Joints		at	\$
	Leadite Joints		at	\$
5	Hrs. Foreman		at	\$ 3.13
2	Hrs. Common Labor	Tapper	at	\$ 1.00
12	Hrs. Common Labor		at	\$ 5.40
	Hrs. Mason		at	\$
	Hrs. Mason's Helper		at	\$
1 1/2	Hrs. Compressor		at	\$ 1.50
	Compensation Ins			\$ 2.9
	Trucking			\$ 1.00
	Builders' Use of Water	Patch		\$ 23.00
Total \$				43.11

3/4" tap at 166 South

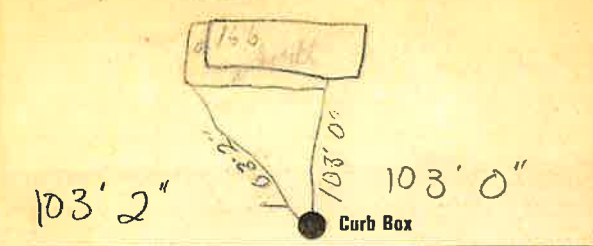

6" Main  
 Elev of Main at tap 41  
 Gate at ● Gate at ●

● Curb Box

8' to main  
 3/4" copper

TAX ID# 309.12-11-19