

174-SOUTH

South


St. ~~Pl.~~ Ave. No. 176

Name of Owner

William Lattimore

Labor and Mat'l. Report

May 28 19 57

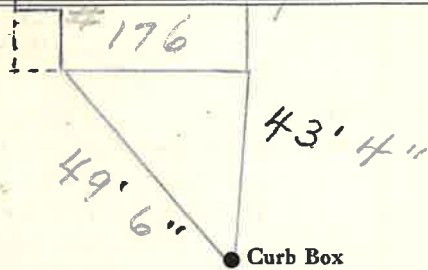

6" Main

Elev. of Main at tap 4 1/2'

Gate at ●

● Gate at

11' to main

3/4" copper

● Curb Box


SOUTH

St. Pl. Ave. No. 176

Name of Owner

TAX ID # 309.12-11-34

Labor and Mat'l. Report 19

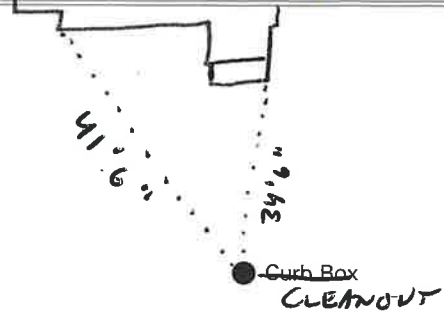

Main

Elev. of Main at tap

Gate at ●

● Gate at

● Curb Box

LABOR AND MATERIALS

~~1~~ Copper } Connection ^{3/4"} \$ _____
~~Lead~~ }
~~1~~ Curb } Cock } 3/4" in. \$ _____
 } Valve }
 } T.S. & V. }
~~1~~ Service box { Short 3 1/2 x 4 1/2 }
 Old returned { Long 4 1/2 x 5 1/2 } \$ _____
 } Buff or Rdway }
~~11~~ Ft. ^{3/4} in. { Copper } Pipe at \$ _____
 } G.I. }
 } C.I. }
 Nipples _____ in. at \$ _____
 Bushings _____ to _____ in. at \$ _____
 Red'g }
 Inc'g } Coupl'gs _____ to _____ in. at \$ _____
 Union _____ in. at \$ _____
 Meter _____ in. at \$ _____
 Lead Joints at \$ _____
 Compound Joints at \$ _____
 Maintenance Foreman \$ _____
 Hrs. Water Maint. Man—1 at \$ _____
 Hrs. Water Maint. Man—2 at \$ _____
 Hrs. Garage Foreman _____ at \$ _____
 Hrs. Labor— _____ at \$ _____
 Hrs. Compressor at \$ _____
 Compensation Ins. at \$ _____ per C \$ _____
 Trucking \$ _____
 Pav't Patch \$ _____
Tap by Gissard & Co. \$ _____
5-28-57 \$ _____
 \$ _____
 O'head \$ _____
 \$ _____

LABOR AND MATERIALS

_____ Copper } Connection _____ \$ _____
 _____ Lead }
 _____ Curb } Cock } _____ in. \$ _____
 } Valve }
 } T.S. & V. }
 _____ Service box { Short 3-1/2 x 4-1/2 } \$ _____
 Old returned { Long 4-1/2 x 5-1/2 }
 _____ Ft. _____ in. { Copper } Pipe at \$ _____
 } G.I. }
 } C.I. }
 _____ Nipples _____ in. at \$ _____
 _____ Bushings _____ to _____ in. at \$ _____
 _____ Red'g _____
 _____ Inc'g _____
 _____ Union _____ in. at \$ _____
 _____ Meter _____ in. at \$ _____
 _____ \$ _____
 _____ Compound Joints at \$ _____
 _____ Maintenance Foreman \$ _____
 _____ Hrs. Water Maint. Man - 1 at \$ _____
 _____ Hrs. Water Maint. Man - 2 at \$ _____
 _____ Hrs. Garage Foreman _____ at \$ _____
 _____ Hrs. Labor _____ at \$ _____
 _____ Hrs. Compressor at \$ _____
 _____ \$ _____
 _____ Trucking \$ _____
 _____ Pav't Patch \$ _____
 _____ \$ _____
 _____ \$ _____
