

LABOR AND MATERIALS

1 Copper } Connection 3/4" \$
 1 Curb } Cock Valve 3/4 in. (MARKED BY SERIAL)
 1 Service box } Short 3 1/2 x 4 1/2 } SAME
 Old returned } Long 4 1/2 x 5 1/2 }
 } Buff. or Rdway } \$
 12 Ft. 3/4 in. } Copper } Pipe at \$
 } C.I. }
 } C.I. }
 Nipples in. at \$
 Bushings to in. at \$
 Red'g }
 Inc'g } Coupl'gs. to in. at \$
 Union in. at \$
 Meter in. at \$
 Lead Joints at \$
 Compound Joints at \$
 Maintenance Foreman \$
 Hrs. Water Maint. Man-1 at \$
 Hrs. Water Maint. Man-2 at \$
 Hrs. Garage Foreman at \$
 Hrs. Labor- at \$
 Hrs. Compressor at \$
 Compensation Ins. at \$ per C \$
 Trucking \$
 Pav't Patch \$
 Tap made by Peck & Co \$
 O'head MAY-21-1974 \$
 \$

180 SOUTH A

South


St. No. 180
 Ave. No. 180

Name of Owner

Leslie L. COMPTON

Labor and Mat'l. Report

MAY 21 1974

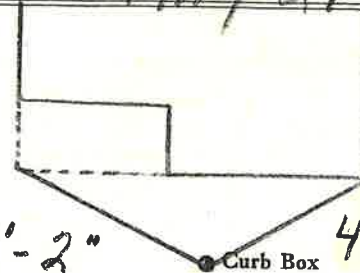

6" Main

Elev. of Main at tap 5'

Gate at ●

● Gate at

12' to MAIN

3/4" copper ● Curb Box

TAX ID# 309.12-11-35 ✓